



7921 A Survey made for Daniel Towan being the SW pt of the East 1/2 of the SW gr. of sec 21. Sp 9 R 7 ¹⁴³

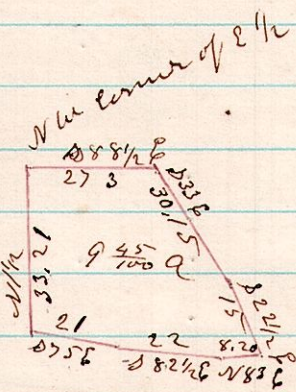

April 10th 1876.

H. H. Robinson
Co Surveyor

7919 A Survey made for Harry Taylor being the South west part of the north East quarter of sec 19, Tp 9, R 7. The same being the south part of lot 36. makes Addition ¹⁴⁴

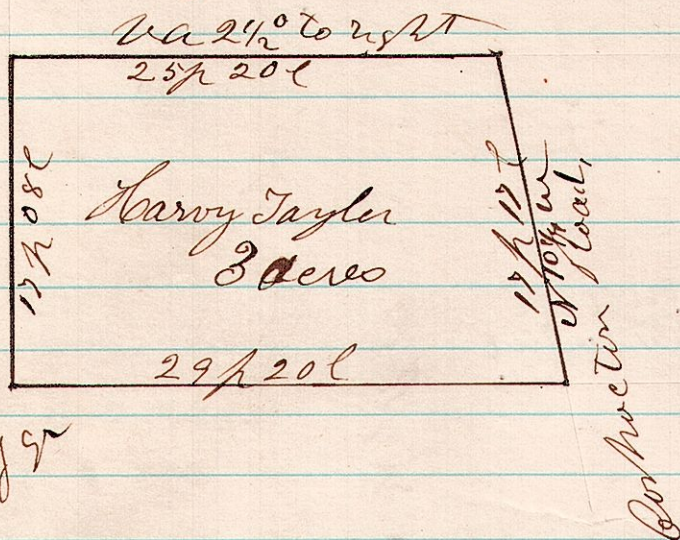

SW corner of gr
April 10th 1876

H. H. Robinson
Co Surveyor