


A survey made for John Hutschison & John Weyman - striking off of the South part of Lot No. 26 in the 3rd Sec Township 9 of Range 8. 45^{ac} more or less by running a line parallel with the South line and 45 feet north of the same. The said division line was run according to the annexed plat -

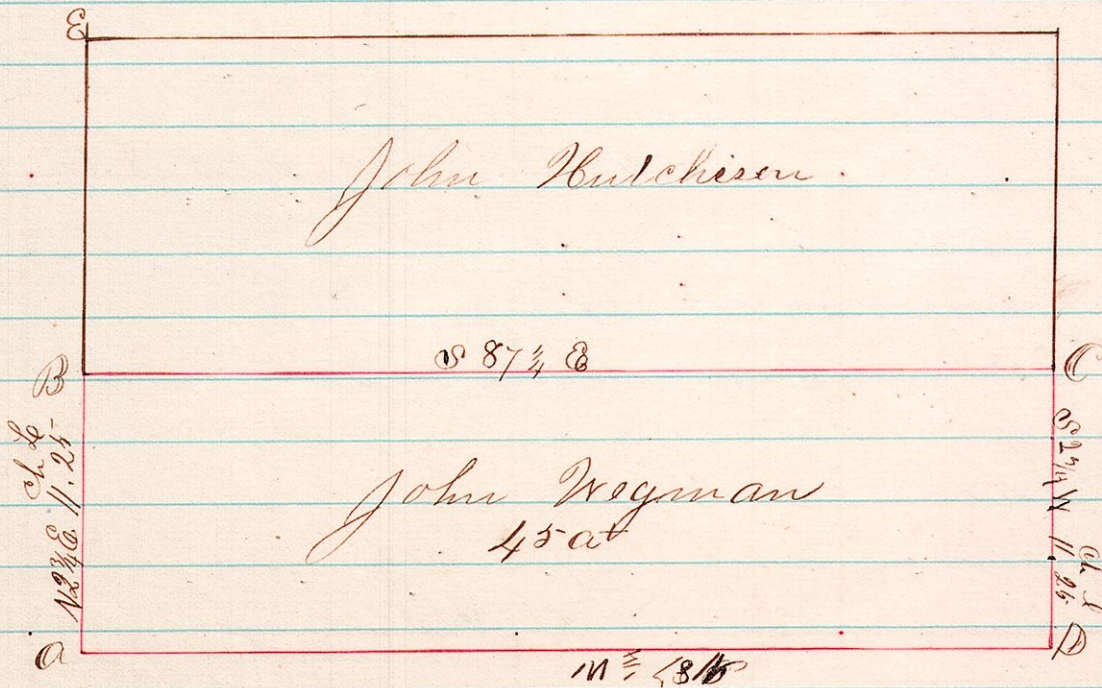

Remarks

The corner at D both witness trees are totally destroyed no new corner established. At A found both trees and the tree in its place which is recorded in this record B may not be on the line as I did not run through to E
I certify the above J. O. Calhoun
Surveyed April 30th 1877
County Surveyor

Sta	B.	In	Chain	Course	Links
A	W. Oak	24	830	E	86
"	Bush	7	N 1/2 E		24
B	W. Oak	14	S 15 1/2 E		21
"	Bush	19	N 67 1/2 E		27