№ 204

14 18 26 A Survey made for Capt Eddy Et. al. to correct description of deeds to suit the intention of parties of the West part of N.E. qr Sec 26 in Township 18 of Range 14

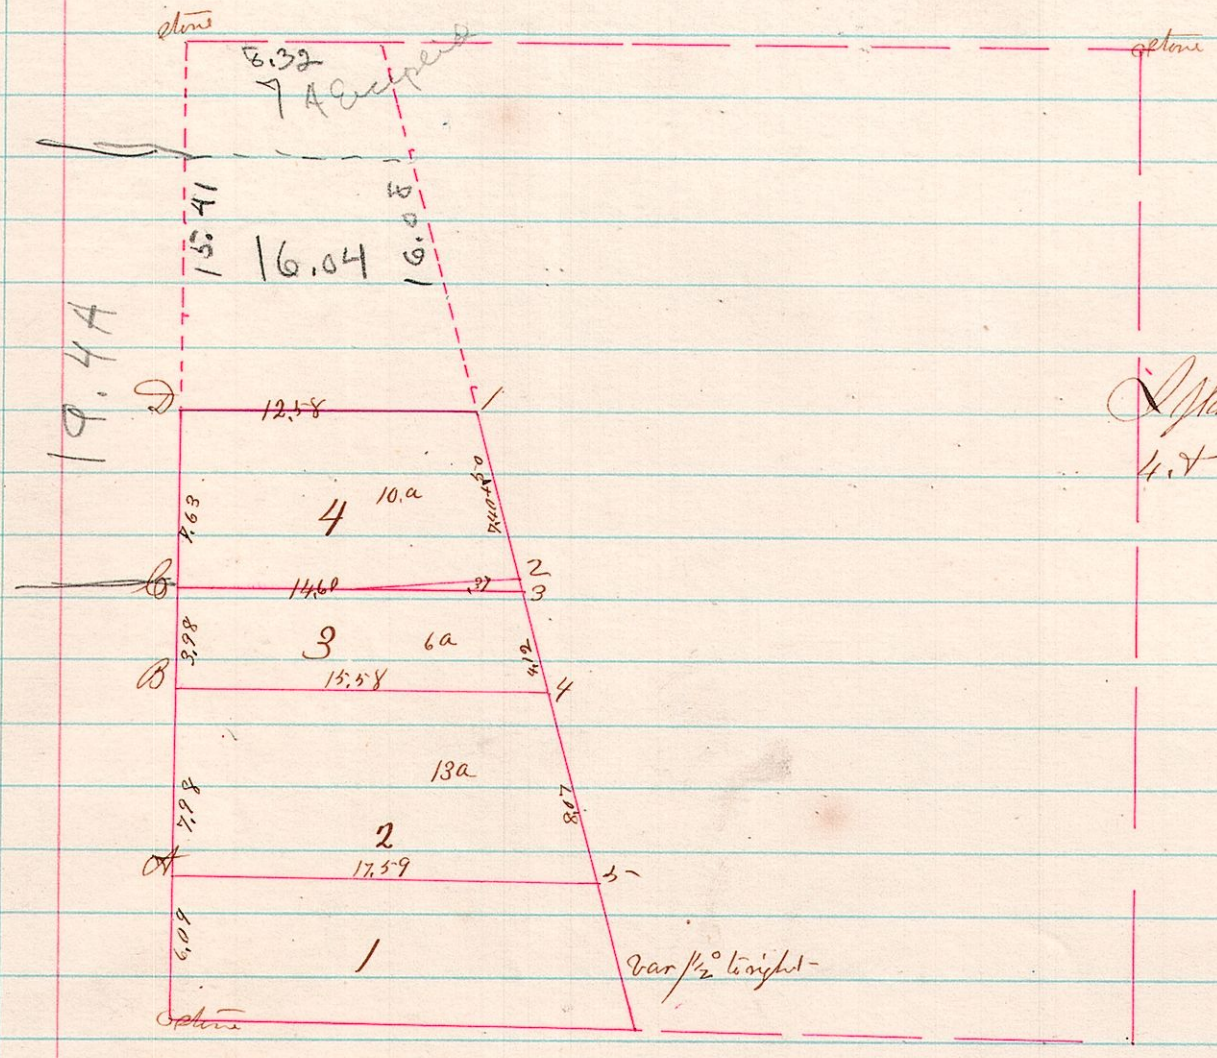

Planted corner stones at A.B.C.D. 123, 4.5-6 Survey April 10th 11th 1878

J.C. Calhoun

County Surveyor

№ 205

15 19 6 A legal Survey made for the purpose of establishing lines and corners in the West half of Section 6 in Township 19 of Range 15. Mr. D.C. Stocker on the 12th day of April 1878 affirmed that he served legal notice according to law at least twenty days before the April 11th 1878 upon the following named persons J.H. Sanborn G.H. Stewart Wm Campbell Herdings his Geo & Mart Heffelfinger Michael Willman and Robinson to that effect and that he proceeded to establish corners according to law as shown in the annexed notes then traced the lines between the corners being partially guided by line trees which he found still standing The following are the field notes taken

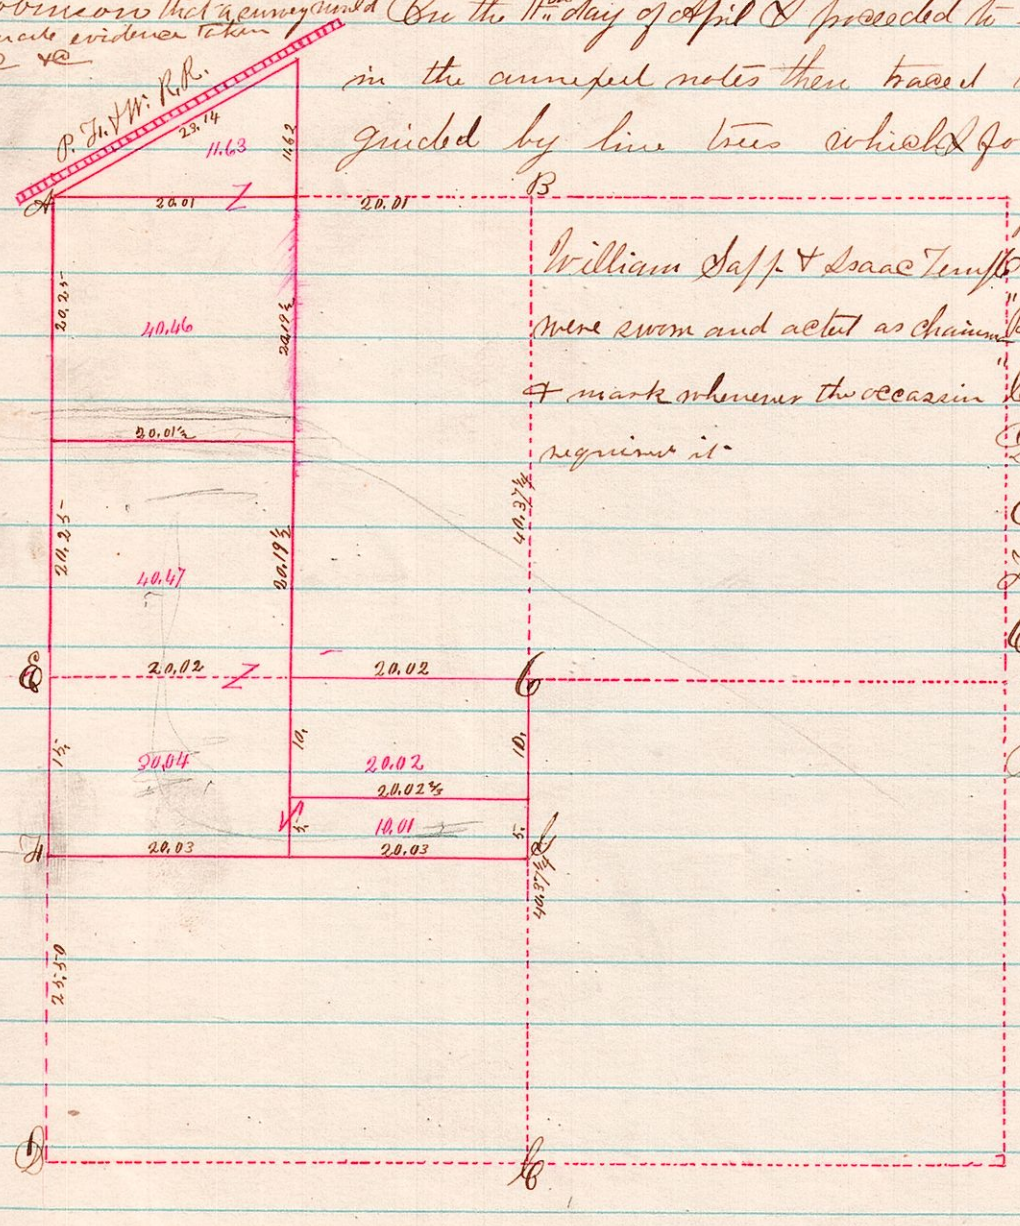

A Planted Stone with R.R. iron L underneath

"B" " H⊕ 17 S 73 W 40 & R.O. 27 S 10½ W 128

C Stone R.O. 8 N 33 E 42 taken by Silvet-

D no bearing trees Taken

E Stake W.O. 33 N 41 W 113½ — tree birch plenty of limbs

F & G Stake no bearing trees taken

Qr Sec. Cor Stake R.O. 16⅔ N 46¾ E 35 & Scrub O 24 S 68¾ W 17½

Var ¼ to ½ to right

Surveyed April 11th 12 1878

J.C. Calhoun

County Surveyor