


7 8 21 86^{er} of 8th Quarter

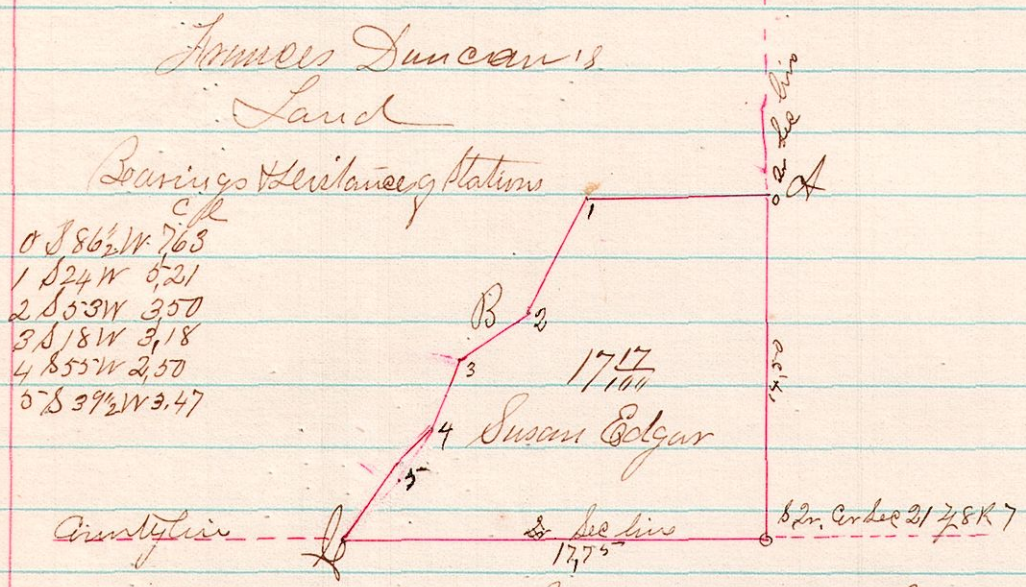

To Francis Duncan widow of William Duncan & heirs

You are hereby notified that a survey will be made and testimony taken by the Holmes County Surveyor on the 4th day of October of 1880 between the hours of 6 o'clock of AM and 7 o'clock of PM and continued from day to day and adjourned from time to time until the lines and corners are legally established in and around my land in the South West 1/4 of Sec 21 in T 8 of Range 7 in McChanic Township Holmes County Ohio

Interested parties are notified to give the Surveyor without delay the names of witnesses they wish subpoenaed and to meet at the residence of Susan Edgar at 6 o'clock of AM on said day before the survey is commenced
 Susan Edgar
 Dated this 13th day of October 1880

The State of Ohio Holmes County

Eduard Carpenter being duly sworn say that he served a true copy of the within notice upon the parties therein named on the 14th day of October 1880 between the hours of 6 to 7 A.M.

Eduard Carpenter

Sworn to and subscribed before me this 4th day of October 1880

J. C. Ballhorn Co. Surveyor

Agreeable to the above noticed proceeded on the 4th day of October 1880 to & did establish the above marked line A-B-C and the corners 1, 2, 3, 4, 5 being the part in dispute and cornered staves to be planted at all the corners excepting 0 & 6 Persons present Mr Patterson Charlie Craig chairman Eduard Carpenter - Wm Duncan

J. C. Ballhorn
 County Surveyor