


332 7 8 22 ch. 11.4

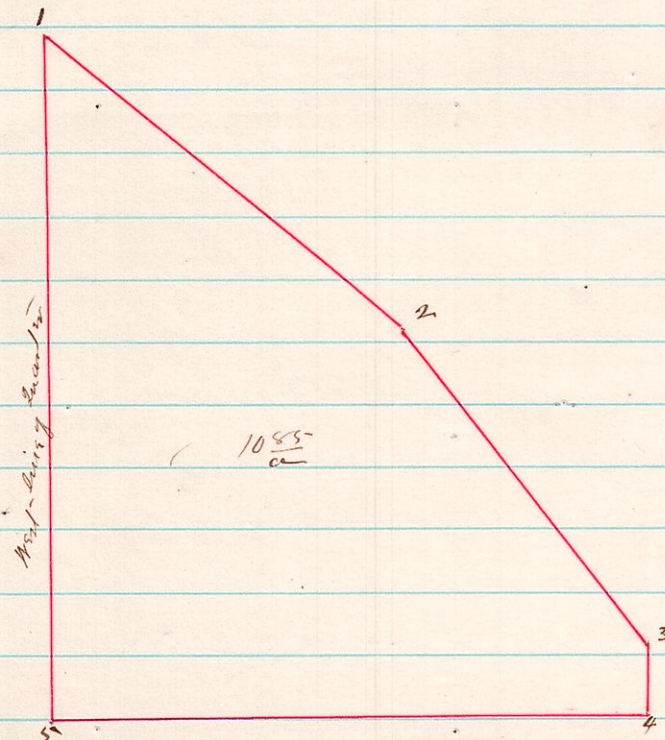

Notes:

- 1 to 2 S 48 1/2° E 967 c
- 2 to 3 S 34 E 828 "
- 3 to 4 S 24 W 160 "
- 4 to 5 S 87 1/2° E 1250 "
- 5 to 1 N 24 E 1275 "

A Survey made for Jacob ^{Huber} of the S.E. part of ch. 11.4
Sec 22 T. 8 R. 7

Surveyed January 1883
James H. Ballou
County Surveyor