



No 340 7 8 5 NW 1/4 Sec 25

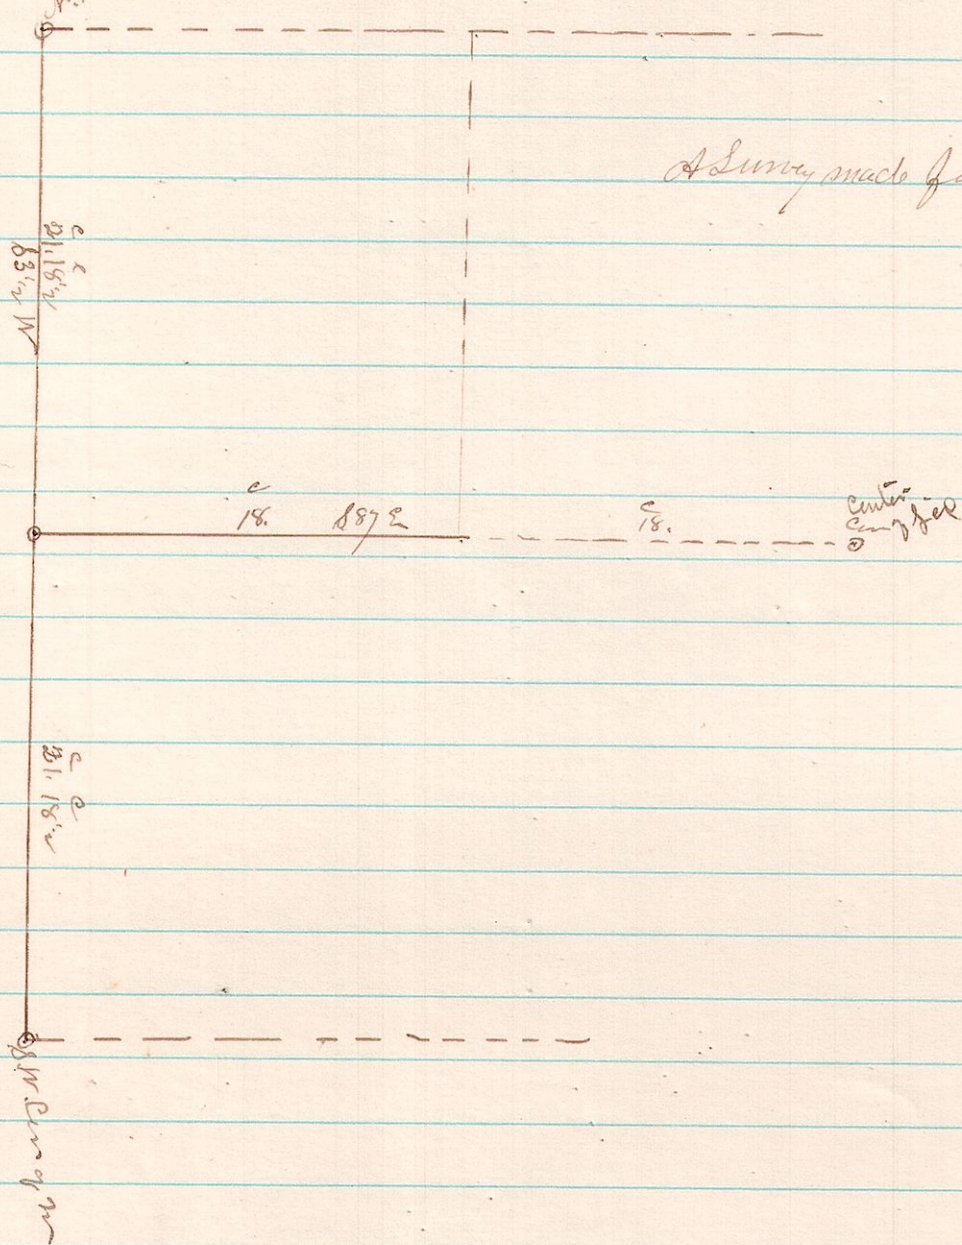


A Survey made for William Johnston March 10<sup>th</sup> 1883

No 341 4 9 25 8<sup>th</sup> Sec 4

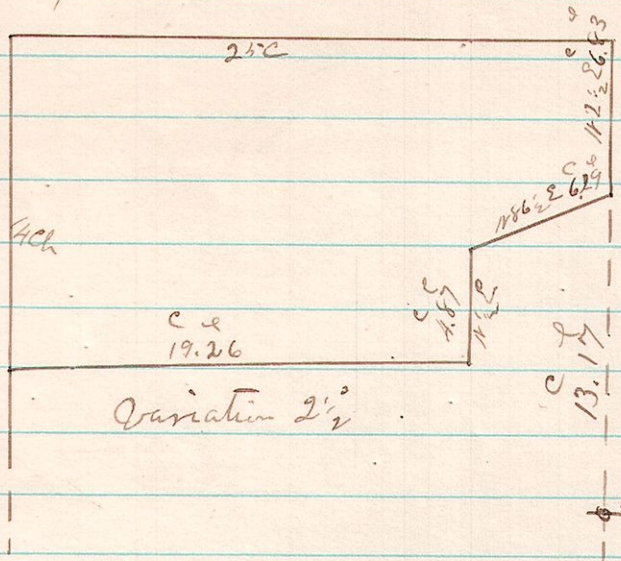

A Survey made for Adam Shei on the 12<sup>th</sup> day of March 1883  
J. L. Ballhorn Surveyor

No 342 4 9 25 8<sup>th</sup> Sec 4

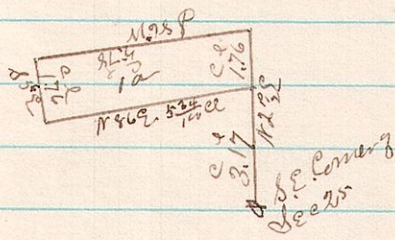

A Survey made for Berry Miller for a school house  
Lot - Surveyed March 12<sup>th</sup> 1883  
J. L. Ballhorn  
Surveyor