



351 5-8 15/25

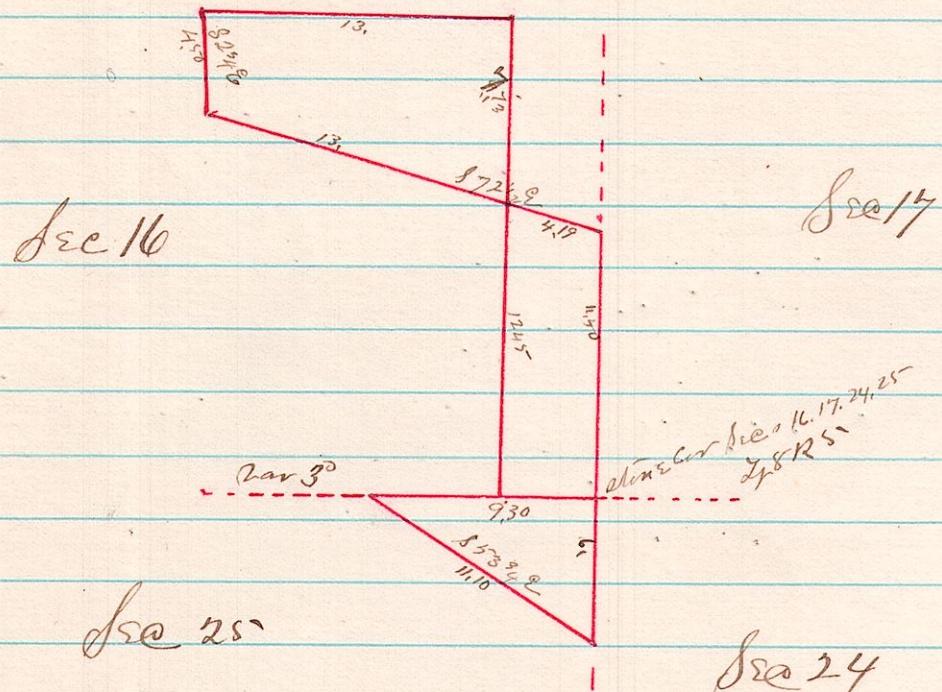

A Survey made for Christian Murray & John Krieger  
 June 13<sup>th</sup> 1883 Gleballum Co Surveyor

352 5-8 17 West line of

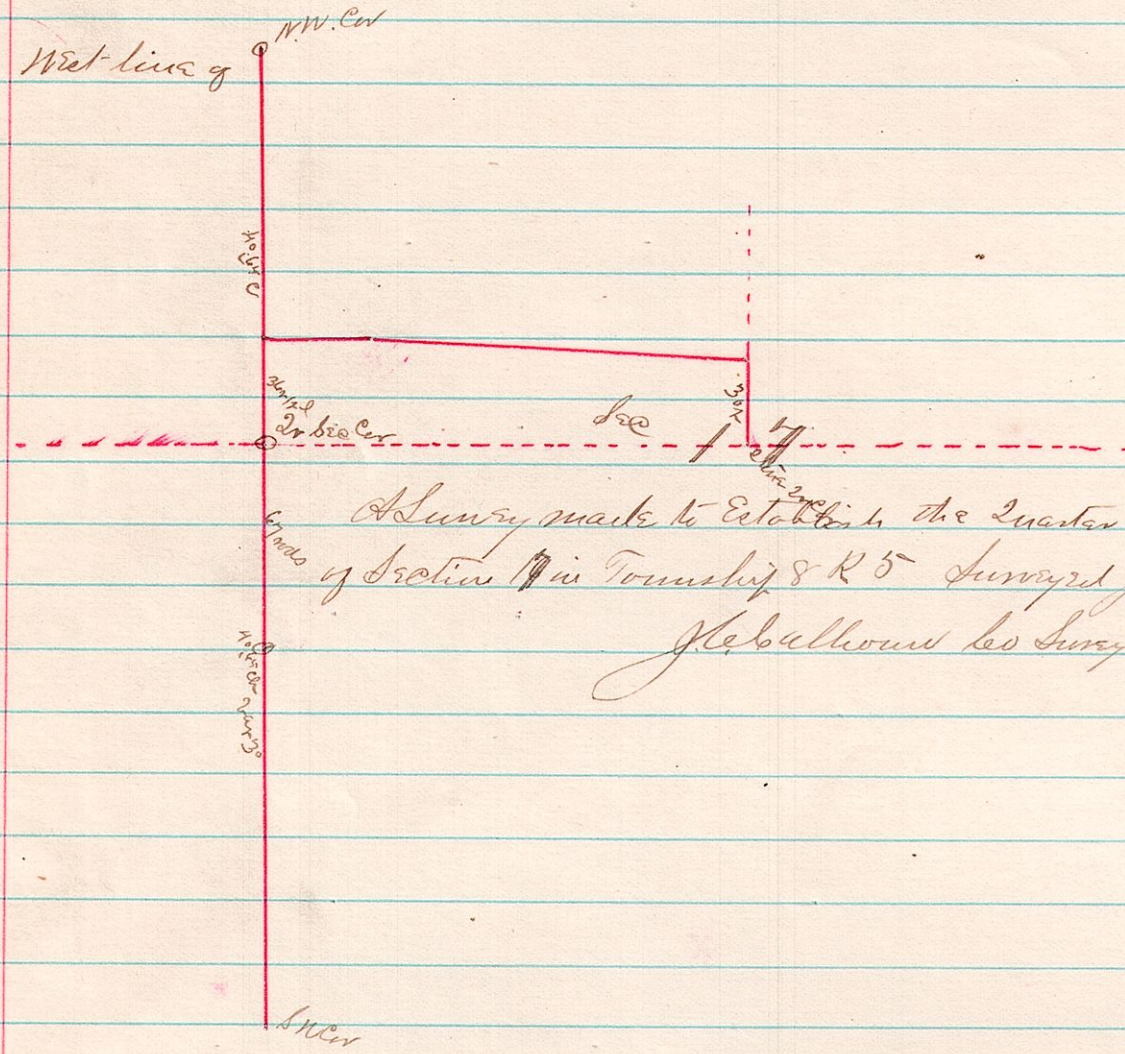

A Survey made to Establish the Quarter corner on the West line  
 of Section 17 in Township 8 R 5 Surveyed June 14<sup>th</sup> 1883  
 Gleballum Co Surveyor

