


445


7 9 18 SE⁴ Alteration of a county road partitioned for by G J Durr et al

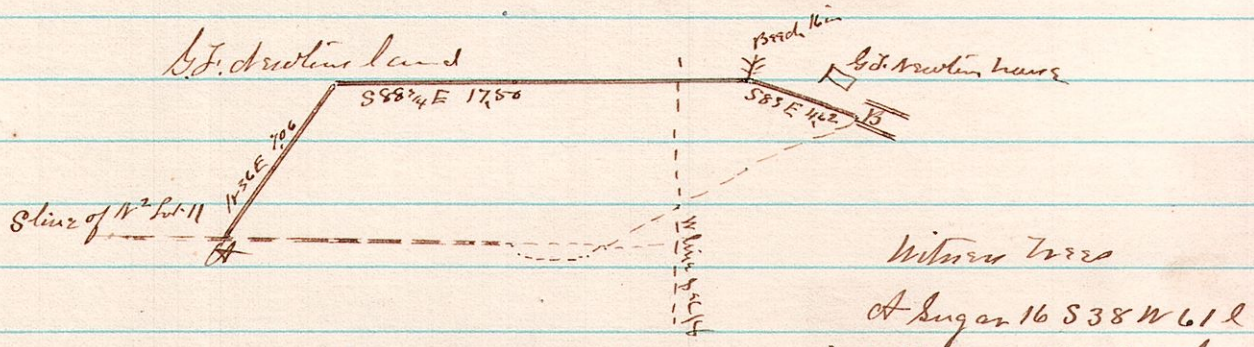

A Survey made by order of the County Commissioners }
 March 17th 1885 Brown better William Coniswell and John }
 J McCulloch were the viewers G. J. Durr & Co. Low Chairman }
 and — — markers all duly sworn }
 James C. Calhoun

446

15 26th 32 + P^r 29 Barbara Priest's Down

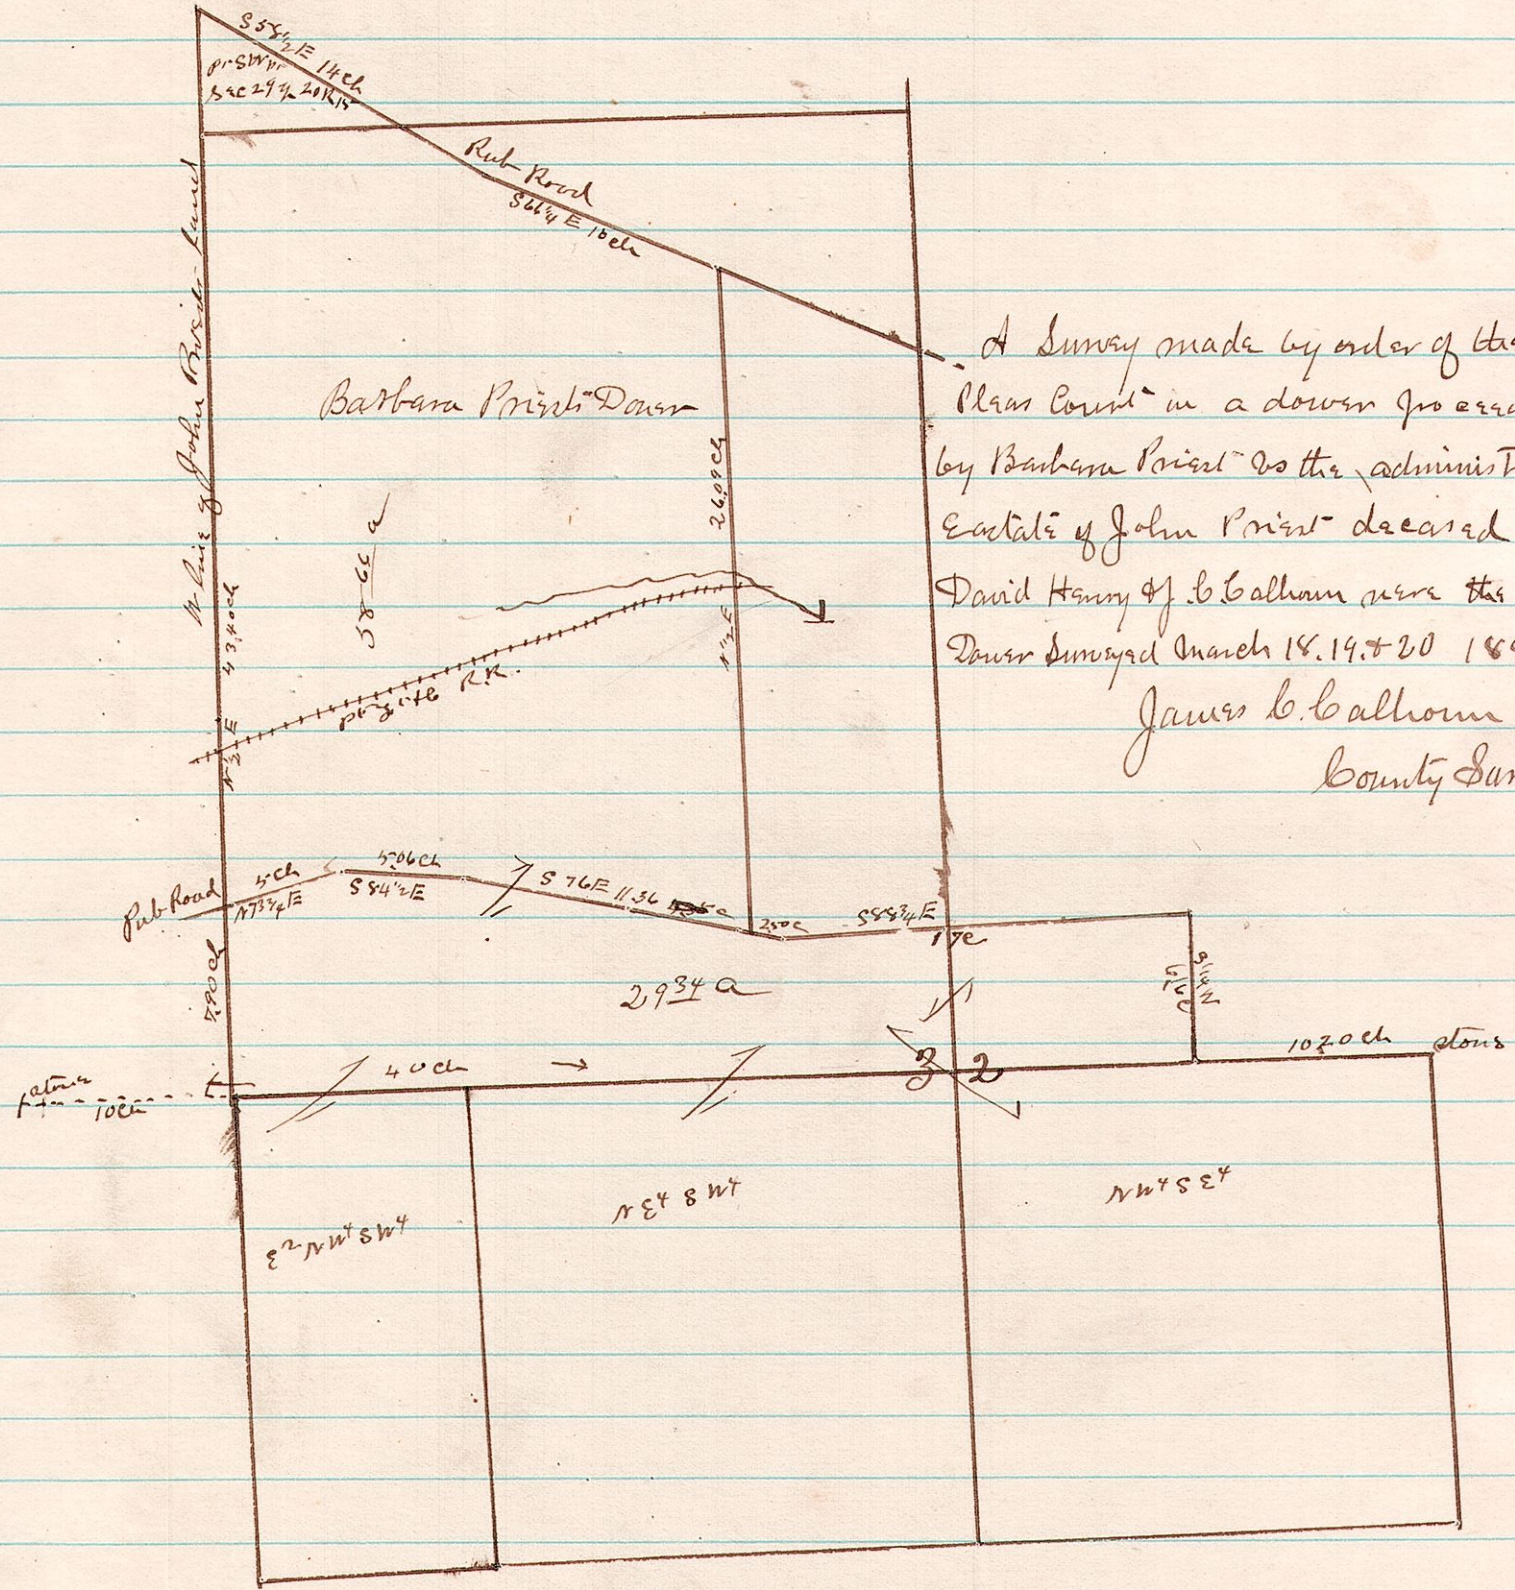

A Survey made by order of the Common
 Pleas Court in a down proceeding brought
 by Barbara Priest as the administrator of the
 estate of John Priest deceased Geo P. Stenback,
 David Henry & J. C. Calhoun were the Commissioners
 Down Surveyed March 18, 19, & 20 1885
 James C. Calhoun
 County Surveyor