455 7 9 3d/4 A Survey made of Bounds local Bainbridge located on Lot 24 Z° 2n 7p 9R 7 in the new entry & in the old entry from the shaft to locate the entries in reference to each other of which the following are the field notes

From air shaft. & old [illegible] N 39° W 23 ft. 2 in S 74½° W 15½ ft. S 3¾° E 2 ch + 25 ft - N 45° W 64 ft - S 88° W 12 ch 7 ft 11 in S 84° W 2 ch 9 ft - 1 in N 89° W 1 ch 6 ft - 5 in S 88½° W 5 ch 5½ ft - 6 in 19 2nd d 38 ft - 8 in S 2½° W 2 ch 50 ch 31 ft - 1 in

From Air Shaft in new Bainbridge 050 Summit N 42¼° E 33 ft - N 24¼° W 15 ft - 10 in S 86¼ W 1 ch 11 ft - 7 in N 3½° E 2 ch 15 ft - 3¾ in N 1½ W 4 ch 12½ ft -

Surveyed March 31st 1885

James C. Calhoun

456

7 9 Town Lots 8. 9. & 10

Comp additions to Millersburg O

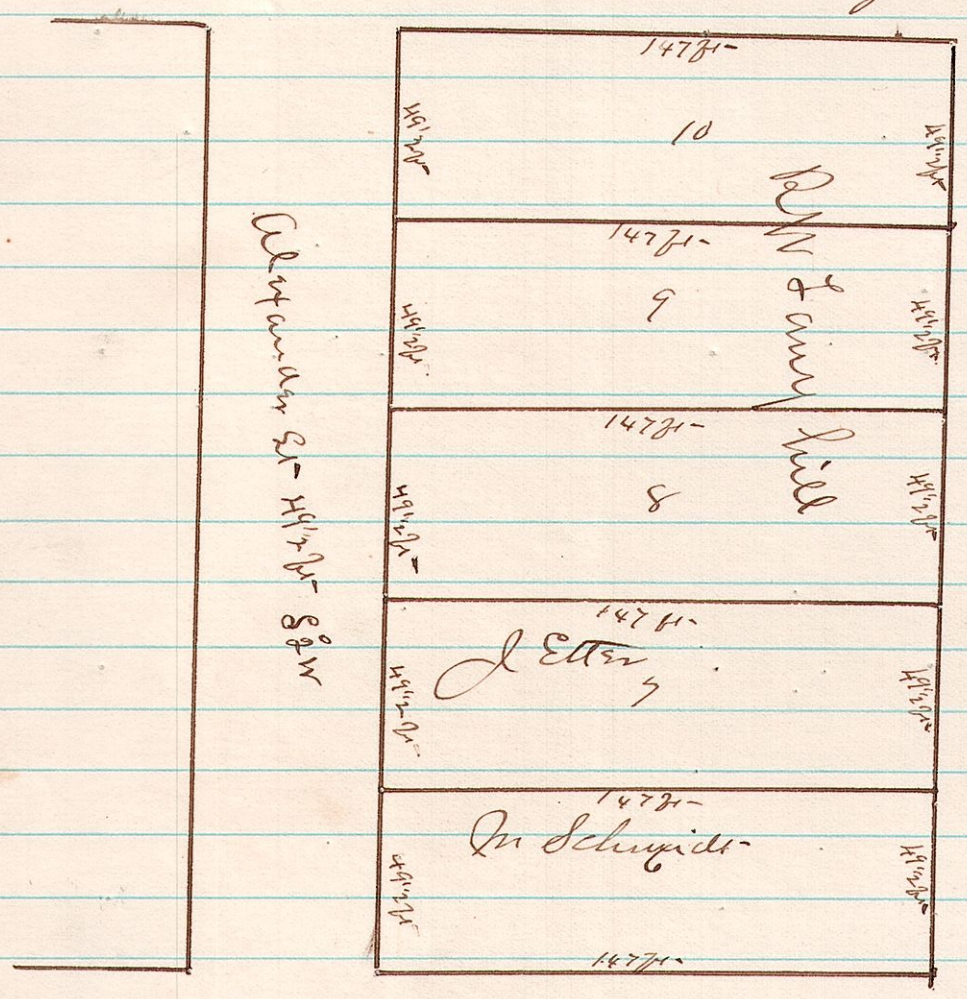

A Survey made for Captain R N. Tannyhill of Lots 8. 9. and 10 in A Comps addition to the town of Millersburg O his for the purpose of locating lines in reference to building there is no established lines in this addition to make Surveys from - I measured on numbering the lots apportioned distances and bearings and found the lines May 9th 1883

James C. Calhoun

County Surveyor