


8 8 7^{1/2} Road

CR6, TR293

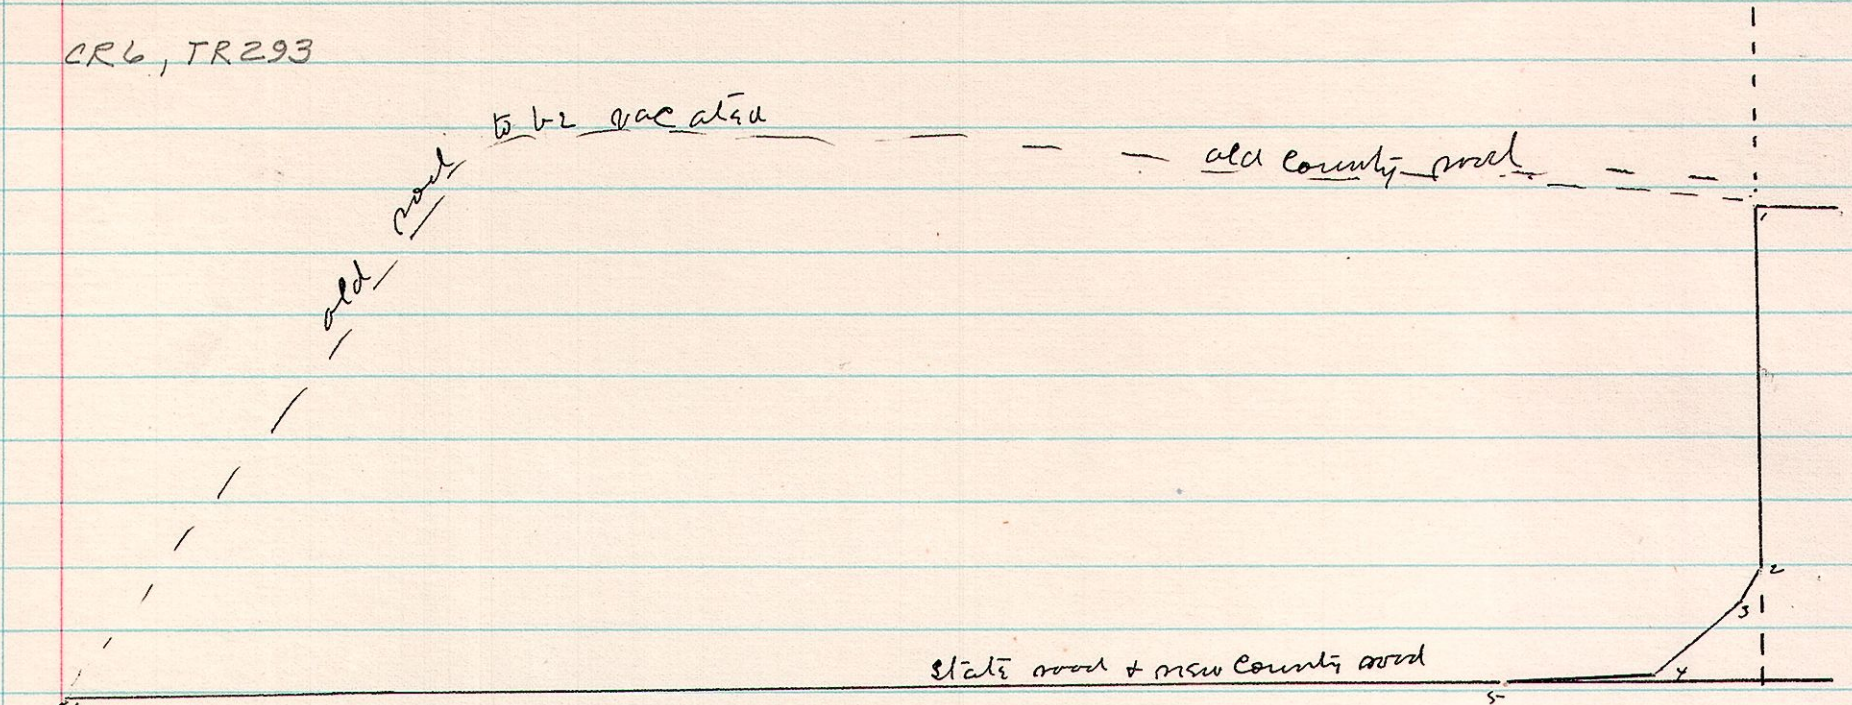

Notes commencing in center of Public road (county)
 on the E line + N⁴ 8^{1/4} W^{1/4} Sec 7^{1/2} 8^{1/2} R^{1/2} E^{1/2}
 from Sta 1

- Thence S 3° W 778
- " S 35° W 81
- " S 52° 1/4 W 239 to State Road 1/2 side
- " S 89° 1/4 W 312 to Cent " "
- " N 87° 1/2 W 34.55 to forks of state & county in S.E⁴ Sec 7 1/2 8^{1/2} R^{1/2} E^{1/2}

A Road surveyed by order of County commissioners being an alteration of a County road petitioned for by C. T. Benson and others William Cressy Russell Chapman and Joseph Carpenter were the viewers Jacobling Patterson and Squire Pinsky chairman and D. Q. Benson a marker all sworn surveyed Dec 22^d 1885

James C. Calhoun
 County Surveyor

7 9 12 Grade of alley between Lots 276, 277 + 280 + 281 Millersburg, W.

	Elevation	Grade	
Center main Anthony St -	55.49	55.49	from village base of bars
Eas. to 33 ft -	51.80		
" " 44 "	52.01		
" " 49 "	56.80		
" " 132 "	65.02		
" " 156 " 1/2 East N ^{1/2} S ^{1/2} alley	68.90	67.40	
" " 165 "	69.89		
" " 198 "	71.56		
" " 228 "	73.17	73.17	
" " 231 "	73.40	73.40	
" " 264 "	75.07	75.07	
" " curbing on Washington St.	76.43	76.43	

A Survey made by order of village council in Spring
 1885 James C. Calhoun
 County Surveyor