No 171

R 7p 2er 2r Pt
15 19 7 Add Cuds

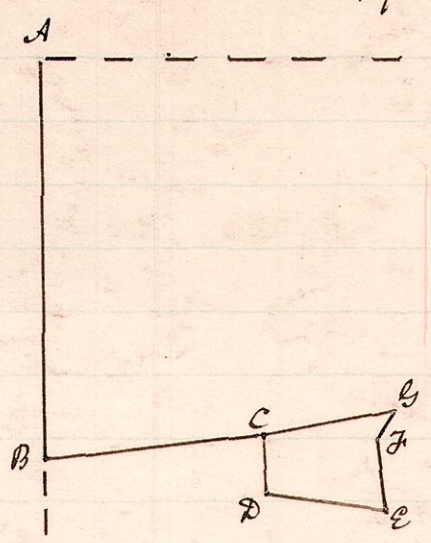

"A" is the N.W. Corner of the N.E. 2r of Sec 7, Tp 19 R 15
A S 1¼ W - 19.15 ch. to B
B N 84¾ E - 5.46 to C
C S 4 E - 2.45 to D
D S 82 E - 2.81 to E
E N 4½ W - 1.82 to F
F N 25 E - .69 to G
G S 85 W - 3.13 to C

Witness to C Apple 6, S 2 W 22
BC is along the center of a road

Surveyed the above for the Board of Education of Washington, Tp Holmes County Ohio, Feb. 13, 1884
W. S. Hanna
County Surveyor

No. 172.

R Tp Sec 2r
15 19 4 NE SE

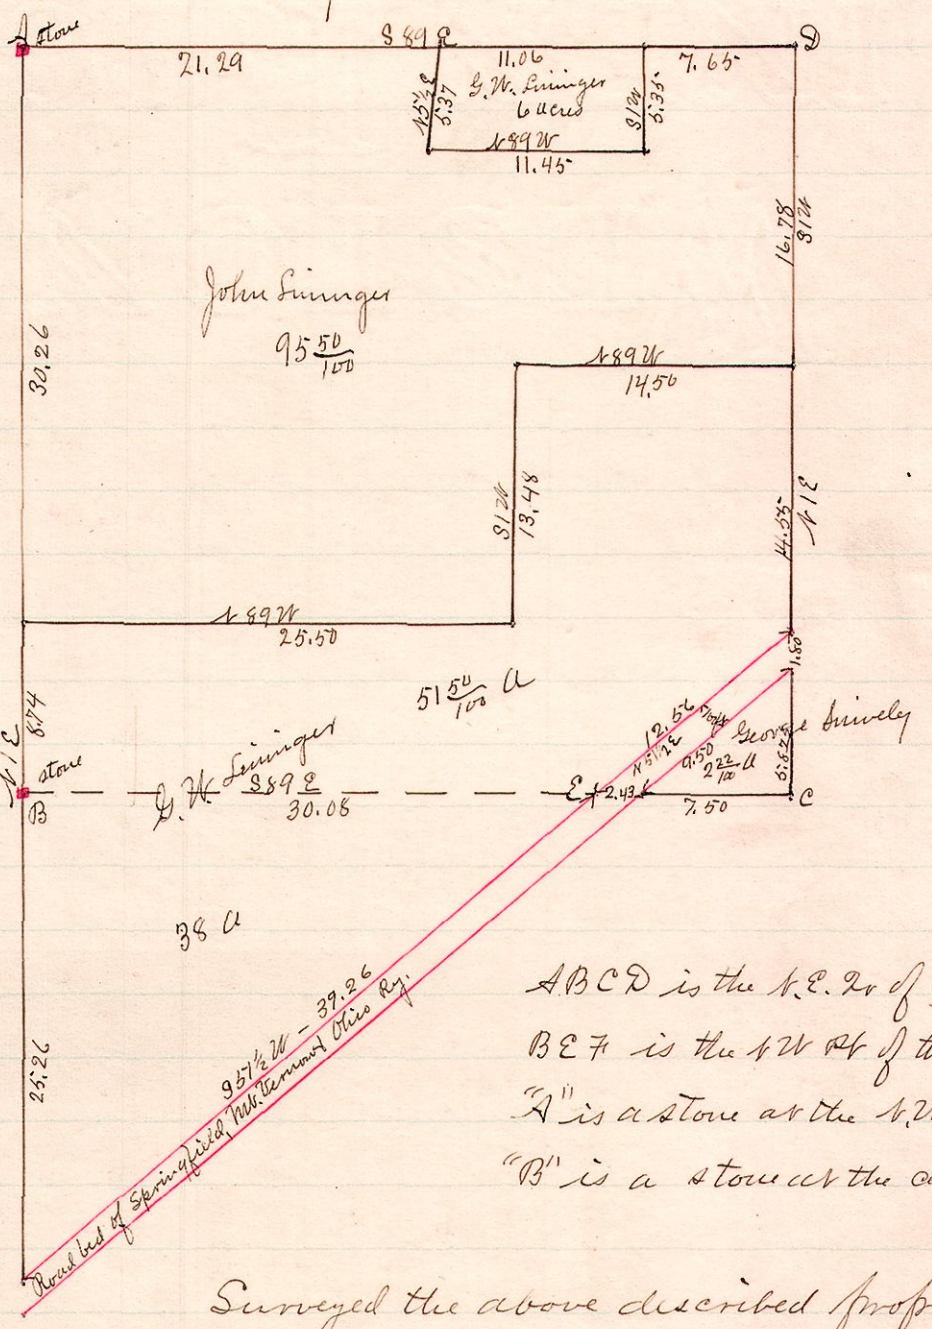

ABCD is the N.E. 2r of Sec 4, Tp 19 R 15
BEF is the W Pt of the S.E. 2r of Sec 4 Tp 19 R 15
"A" is a stone at the N.W. Cor of the N.E. 2r
"B" is a stone at the center of said section 4

Surveyed the above described property and made a division of the same as shown on the plat Feb 13, 1884
W. S. Hanna
County Surveyor