


No. 339

14 18 29 NE 1/4

T R 375 @ S.R. 226

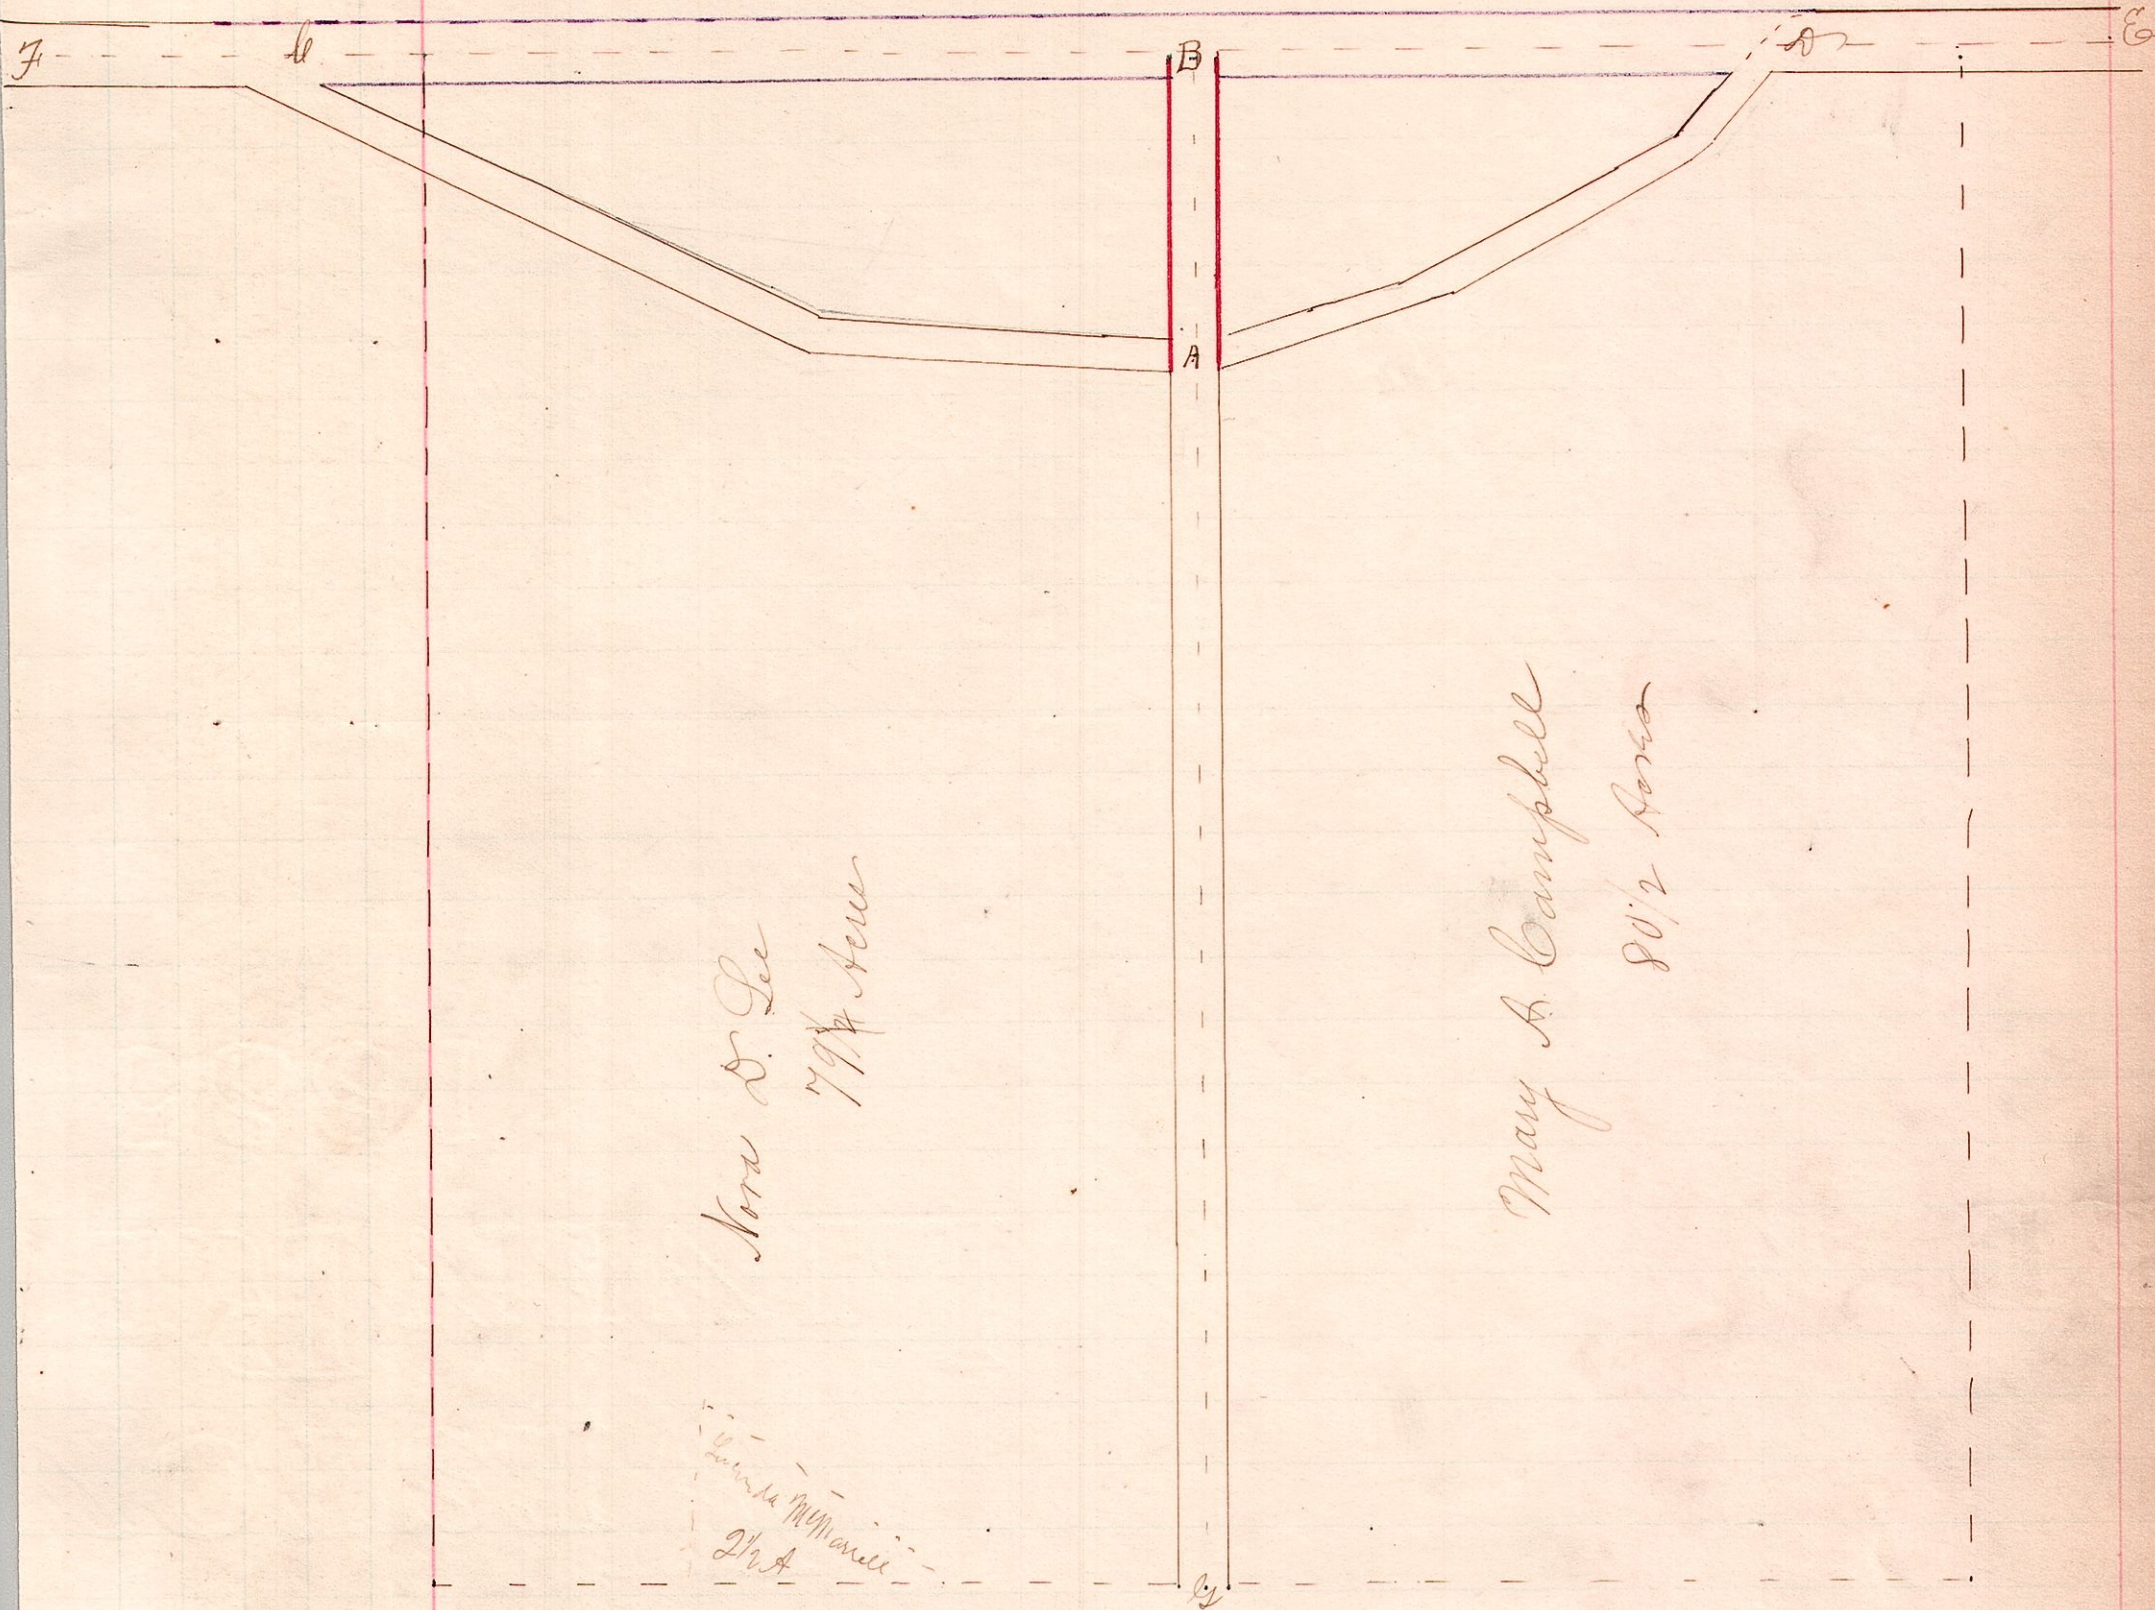

Notes

From A to B is the proposed Establishment of Road as Surveyed  
 A B is 28 rods long. Bearing N 1/2 E.

B is a stake on County line, The terminus of proposed Route.  
 A is a stake at south side of old Road to A.D., and is the place of beginning  
 Witness to A. - White Oak 30 S 12 1/2 E 197 links.

C B C is another proposed alteration of the road Ed A C F so as to  
 be on the County Line, Ed B C C.

W B is the dividing line running North and South between the  
 East and West halves of the NE 1/4 of Sec 29 T 18 R 14. (Reply 7/2)

Joseph Cole  
 Samuel J. Cutler } Commissioners  
 Milton Hanna

Miner Hider  
 James Scott } Chairmen  
 Samuel Seute, axman

Surveyed by the order of the County Commissioners  
 July 23, 1891  
 Frank H. Genet  
 County Surveyor.