


Notes

"A" southeast abutment of bridge  
across Boughty Creek -  
"B" a post S 66° E 15 rods 10 c from A  
"C" a .. S 84° E 62 " .. B  
"D" .. N 83° W 12 ch 88 c .. C  
"E" a post N 52° E 13.18 ch .. D  
"F" a stone in old road  
N 34° E 21.58 ch from E

Road located in  
Lots 2<sup>nd</sup> & 1 of the  
4th 2<sup>nd</sup> Tp 9R 6 and  
Lot 21 of the 1st 2<sup>nd</sup> Tp 9R 6  
Petitioned by John T Miller  
and Surveyed by J. C. Calhoun  

Viewers  
H. N. Robinson  
N. Wolgamot  
Philip DeGraff

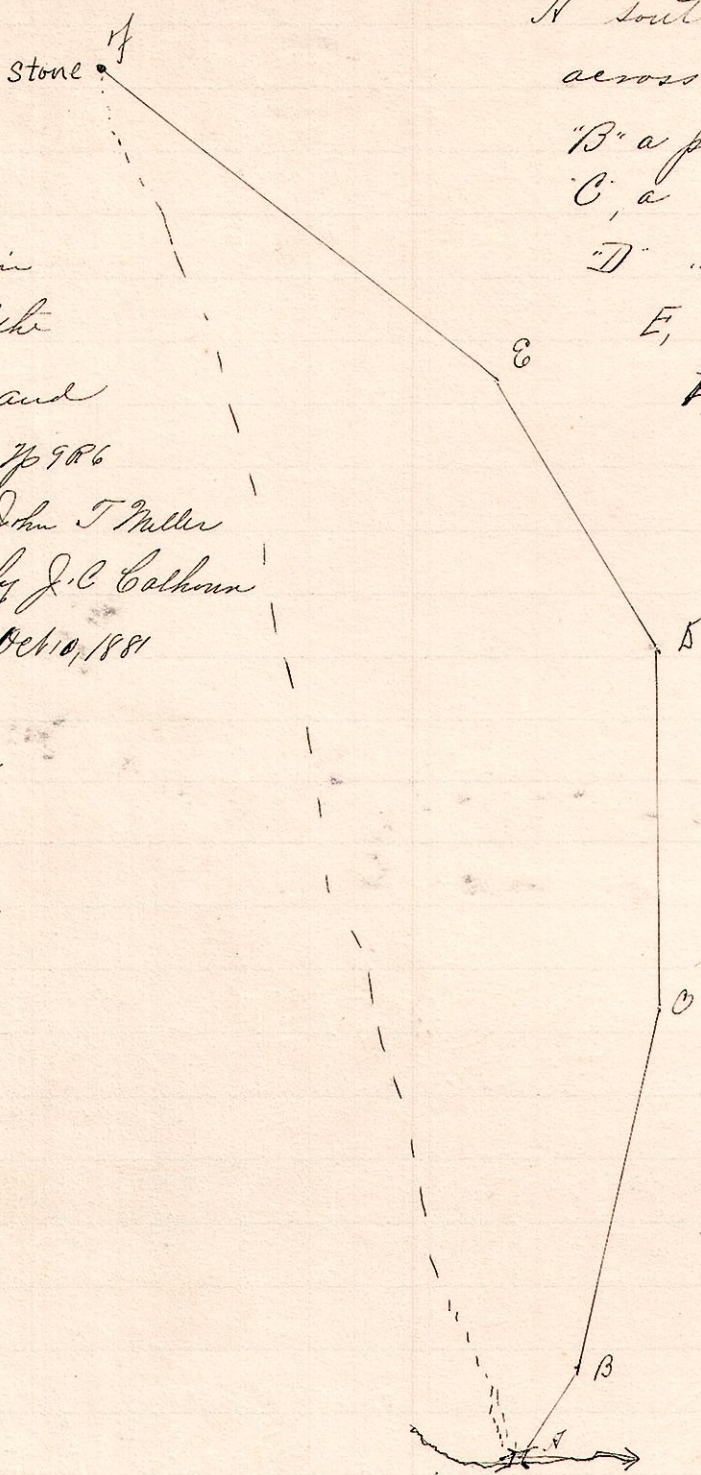

R Tp 14<sup>th</sup> Lots  
6 9<sup>th</sup> 2 and 1  
1st 21  
SR 39

