


No. 412.

N. Stone

Notes

- "A" stone at NW corner N & 2^d Sec 9 T₈ R₈ E
- "B" a post S 3 1/4° W 70 rods from A - at side public road.
- "C" a post at NW corner school lot in center of road leading from Pictoria to Millenburg S 5 3/4° E 17 p 20 l from B
- "D" a post in said road S 37° E 16 p from C.
- "E" " " " N 86° E 12 1/2 p from D.
- "F" a stone at the northeast corner of said school lot, 16 p N 37° W from E and 12 1/2 p N 86° E of C.

R 7th Sec 2^d
8 8 9 16 p

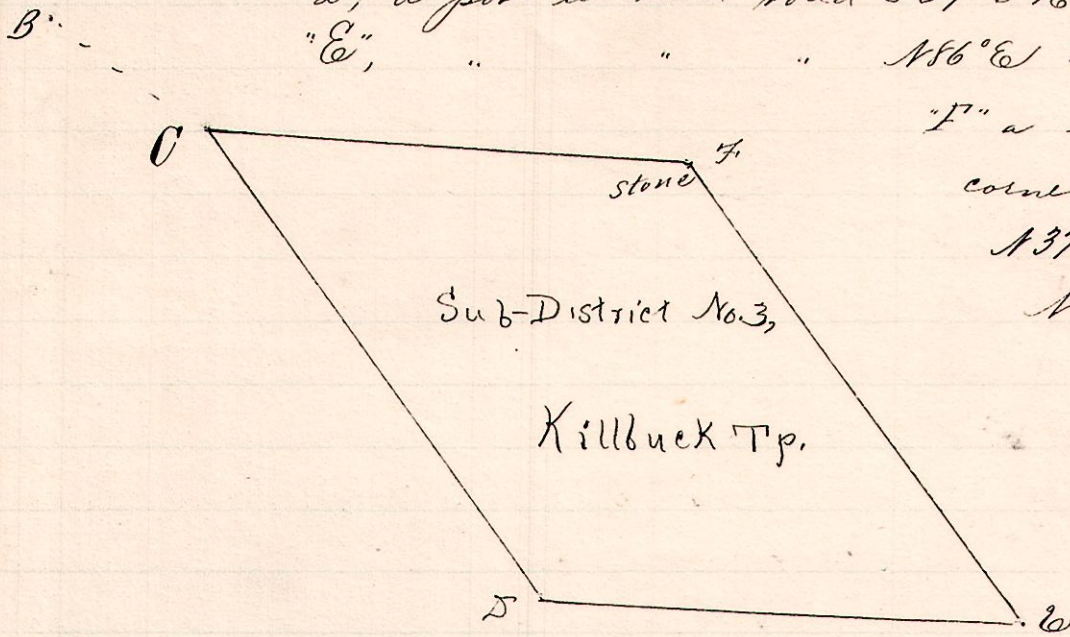

Chainmen
 Samuel Gray
 Stuart Kimball
 F. J. Anderson, marker

Surveyed the above School Site for
 the Board of Education of Killbuck Township & John Anderson,
 June 20 1892.

Frank H. Gunt
 Co. Surveyor.


No. 413.

N. Stone

Notes -

- "A" stone at SE corner Lot 21, 2^d T₈ R₈ E.
- "B" a stone at SE School Lot N 3 1/4° E 42 p from A.
- "C" " " SW " " N 86 3/4° W 10 p " B.
- "D" " " NW " " N 3 1/4° E 16 p " C.
- "E" " " NE " " on East line lot 21 S 86 3/4° E 10 p from D & 16 N 3 1/4° E from B.

R 7th Dist Lot
 6 8 2nd 21 E p

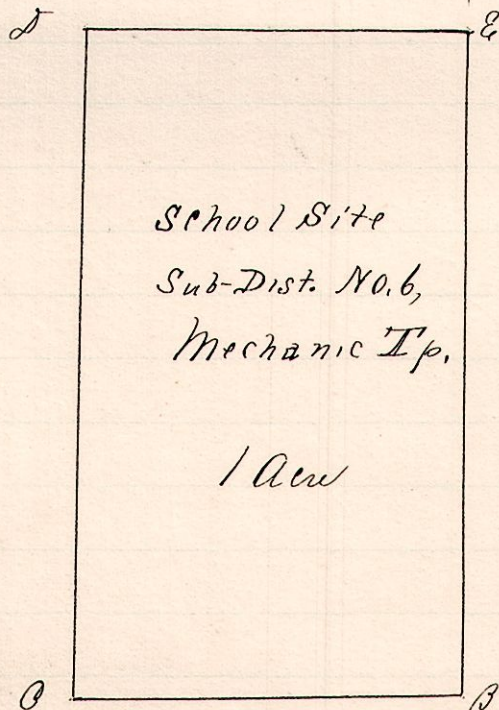

Chainmen: (sworn)
 August Schlegel & Chas. J. Gunt
 Markers:
 John Fleming & Thos. Patterson,
 David McCaskey, Assman

Surveyed for the Board
 of Education of Mechanic T_p
 and Thomas Patterson
 June 13 1892.

Frank H. Gunt
 Co. Surveyor
 Holmes Co. O.

Stone A