


No. 438.

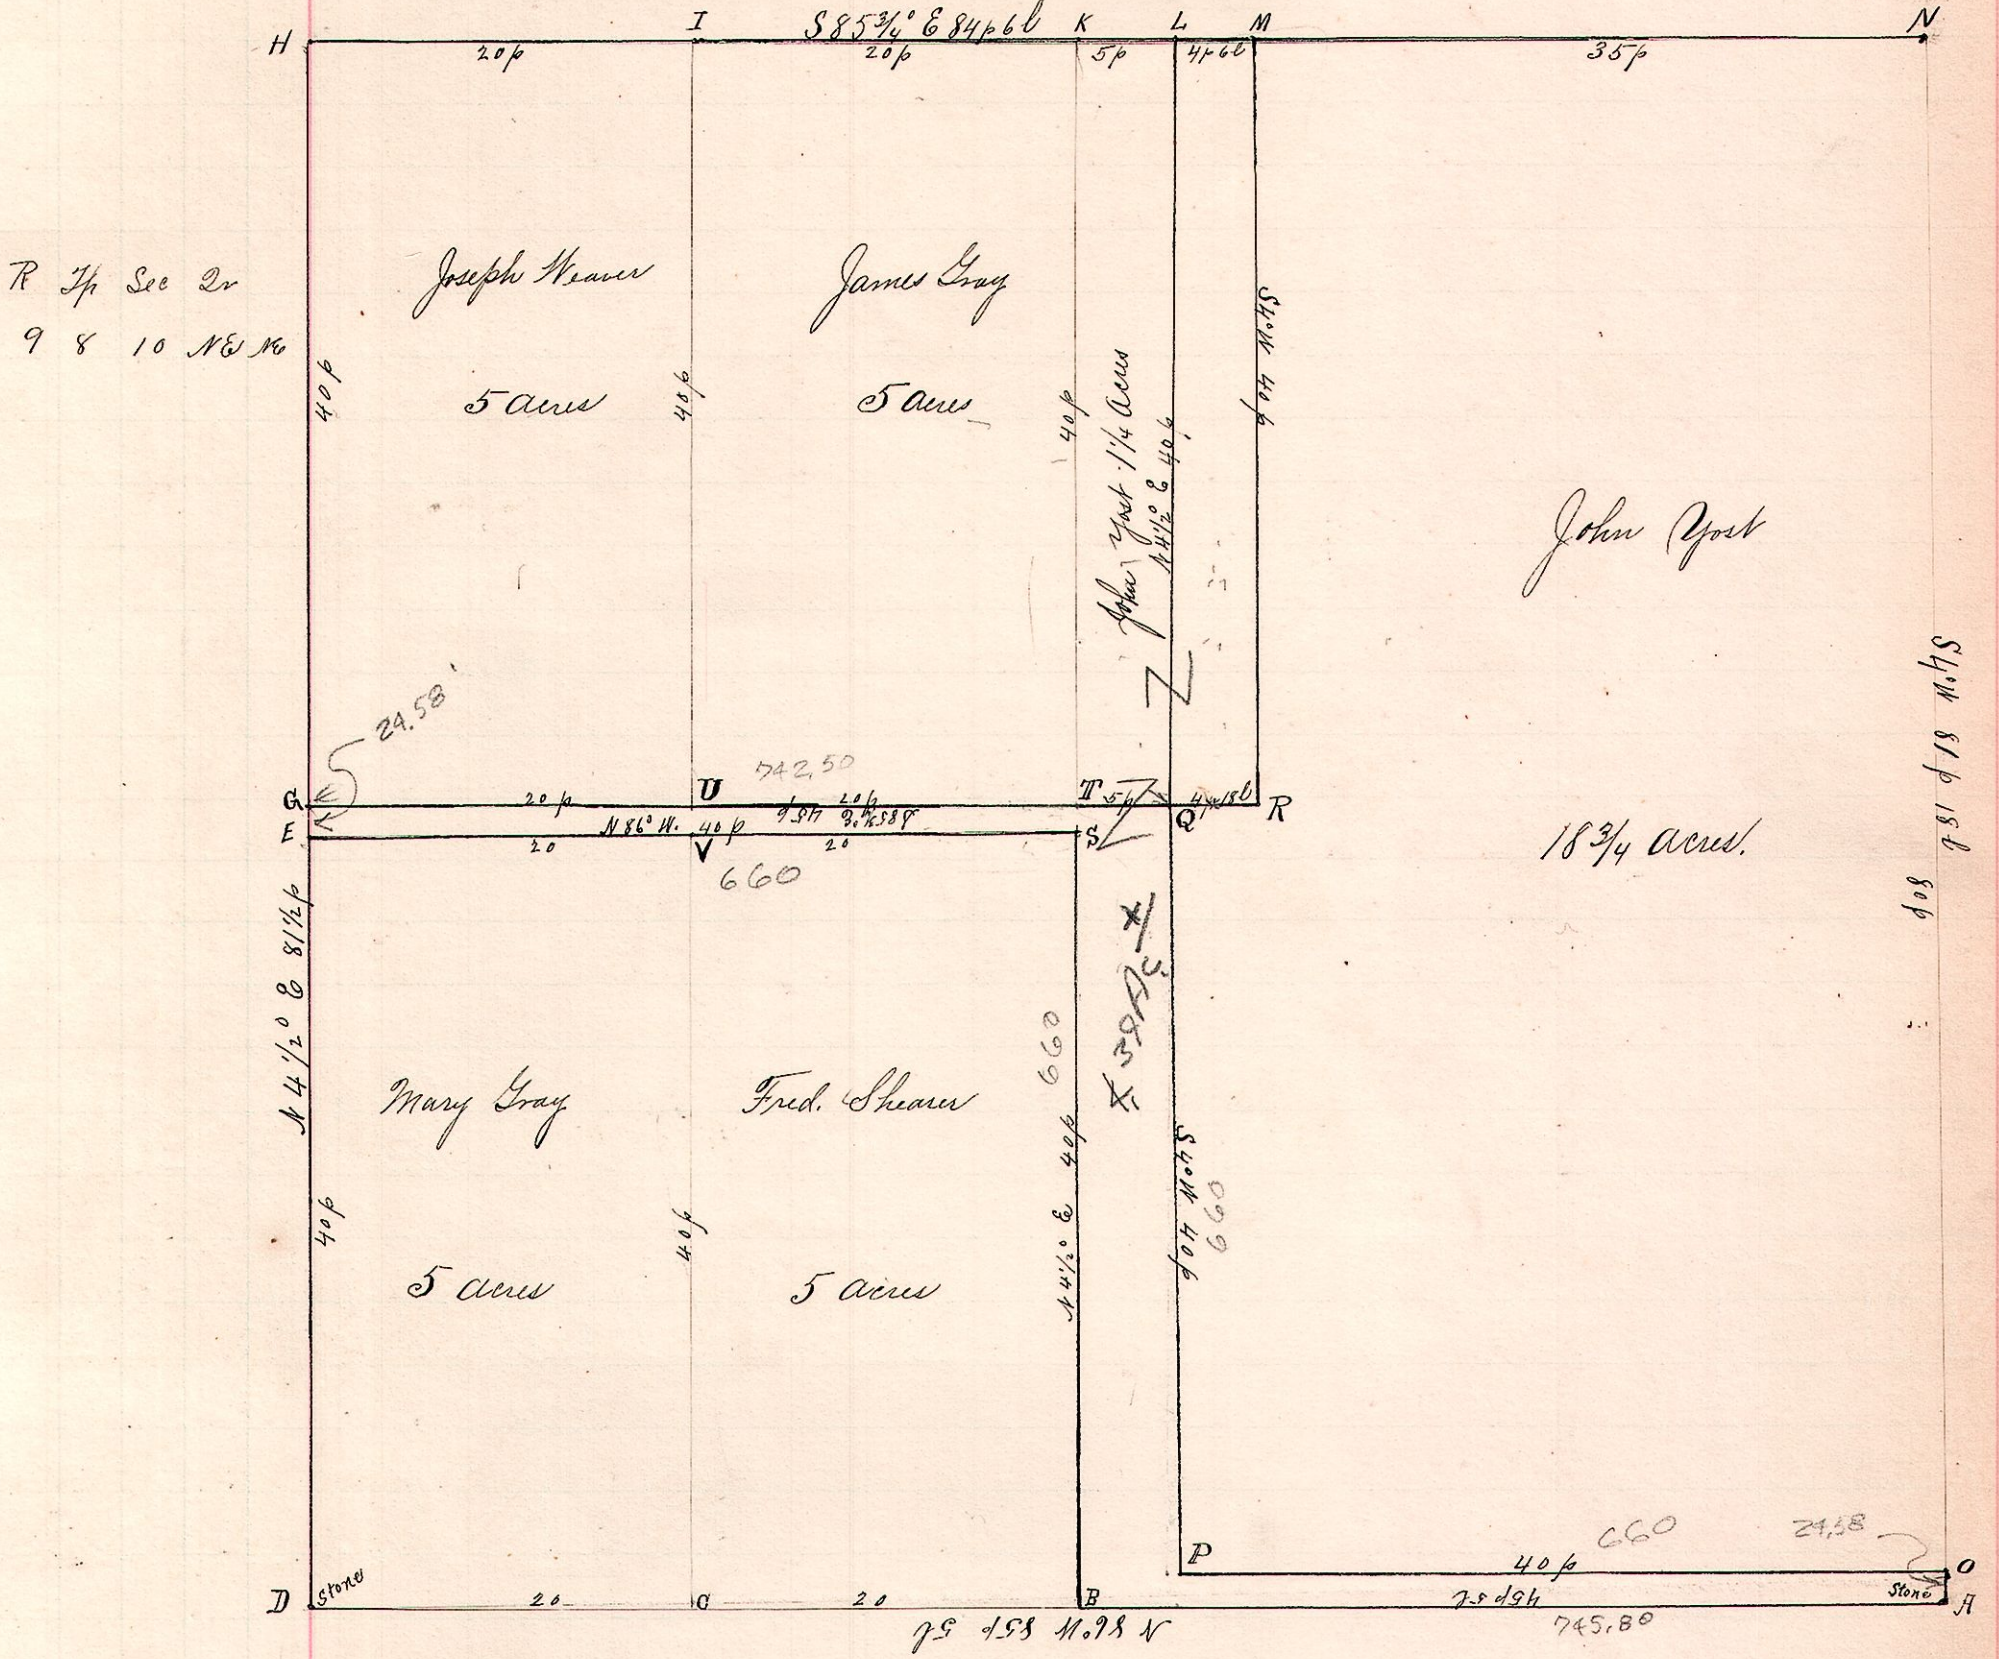

The above is a correct plat of the several tracts of land in the northeast quarter of the Northeast Quarter of Section 10, Township 8, Range 9, as surveyed for, Paul Daniels, John Gort, Fred. Shearer, et al, August 10, 1892.

Frank H. Gunt, Co. Surveyor.