


R 7th Sec 2^d
7 8 13 NW Ept

Silas Gray

G. C. Quillen

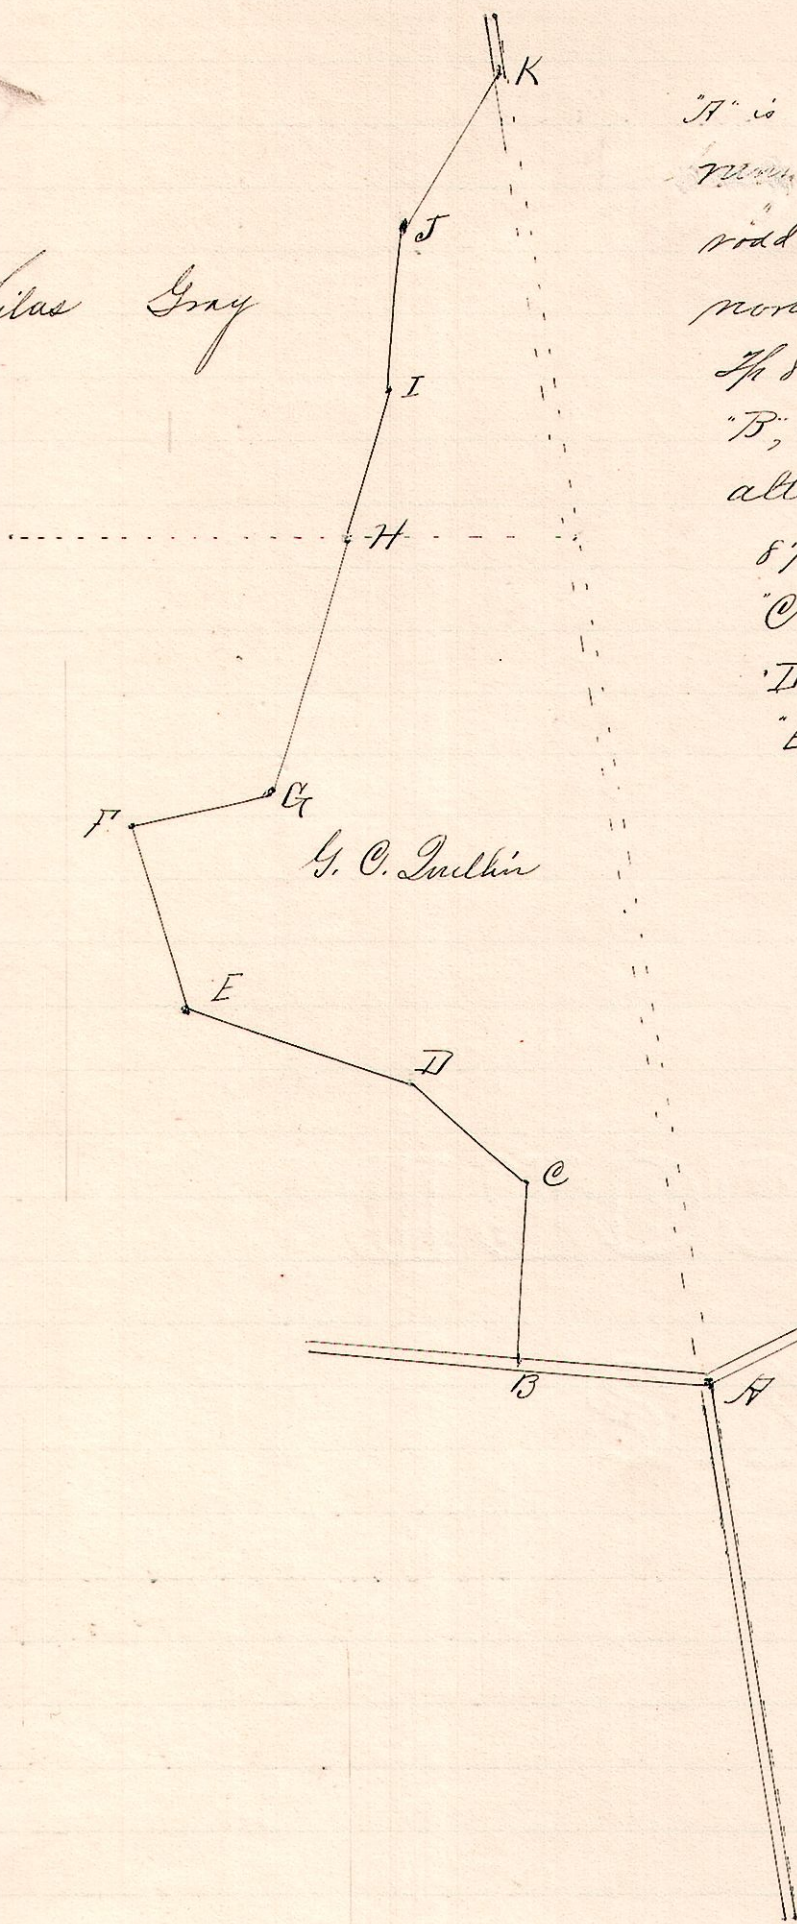

Notes

"A" is a stone at intersection of road running North and south with road leading to Killbuck in the northwest quarter of section 13 T^h 8 R 7

"B" the place of beginning of proposed alteration is a post in old road 8 1/2 fences N 87° W from H.

"C" is north 7 rods from B

"D" is N 23° W 4 p 20 l from C

"E" is N 53° W 10 p " D

"F" is N 18° W 6 p 8 U " E

"G" is N 71° E 5 p from F

"H" is N 33° E 10 p from G on line between Quillen + Gray

"I" is N 33° E 7 1/2 p from H.

"J" is N 25° E 6 p " I.

"K" the terminus of Alteration is N 53° E 7 1/2 p from "J."

Witness to "K"

{ Beech 18 S 36° E 50 l
Wash 10 S 32° W 69 l

- Chainmen -

Harry Uhl

F. S. Anderson

Master - L. H. Uhl.

- Viewers -

Charles S. Uhl

James Carpenter &

Samuel Devore,

Surveyed the above alteration of a county road in the Northwest quarter of Section 13 T^h 8 R 7, by order of the County Commissioners, Sept 20, 1899.

Frank N. Gault,
County Surveyor.