


No. 454.

R. 7th Sec. Lot  
7 9 3d 2 4th

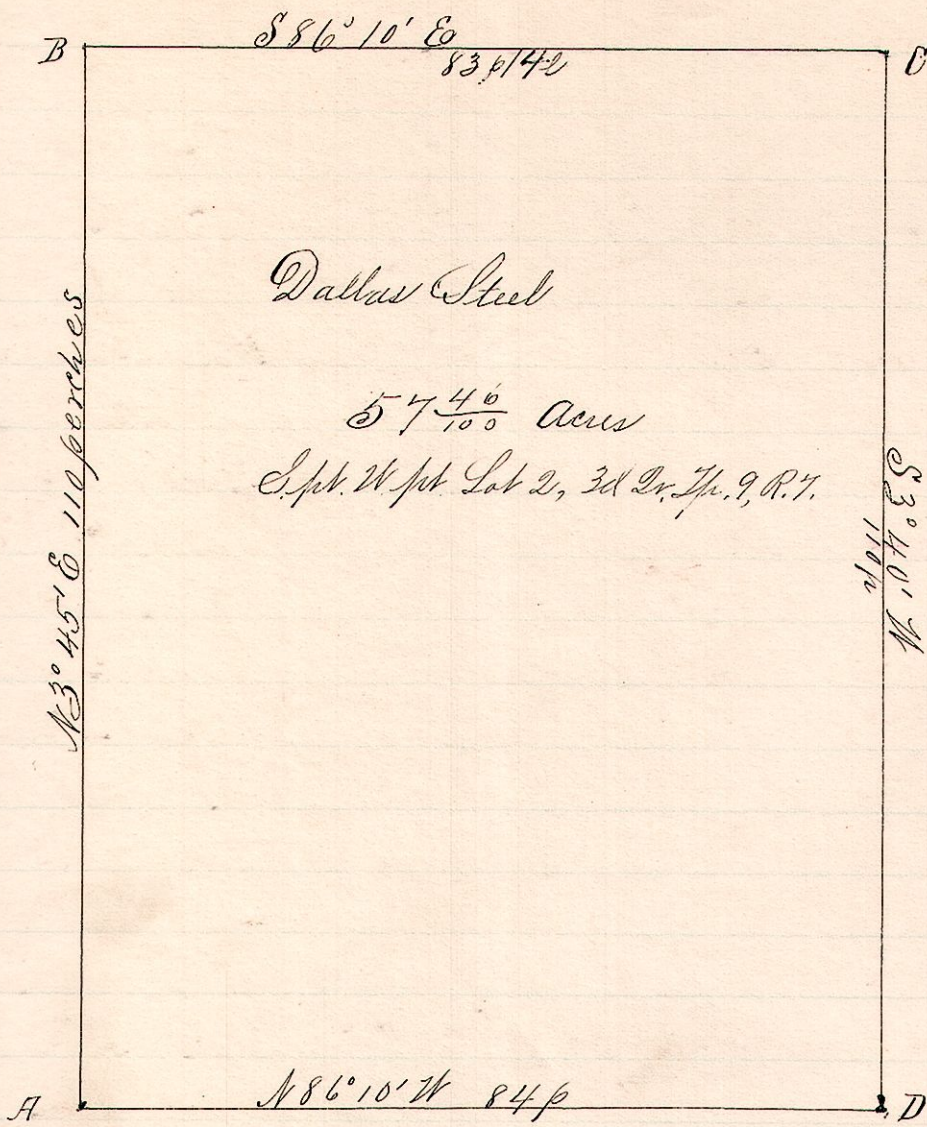


Notes:  
 A is the southwest corner of Lot 2, 3d 2, 7th, 9, R. 7.  
 B, a post on west line of said lot N 3° 45' E 110 p from A.  
 C, a post on north line of lot S 86° 10' E 83 1/4 p from B.  
 D, a post on south line said lot 110 p S 3° 40' W from C and 84 p S 86° 10' E from A.  
 Chairman:  
 C. T. Bickel  
 David Bilderbach  
 Member:  
 Edw. Uhl.

Surveyed the above for Dallas Steel, by request of Cyrus Uhl and David Bilderbach, Admins George W Uhl estate. Nov. 23, 1892.

Frank H. Gunt,  
County Surveyor.

No. 455.

R 7th 2nd Lot  
7 9 3d 2 Ept

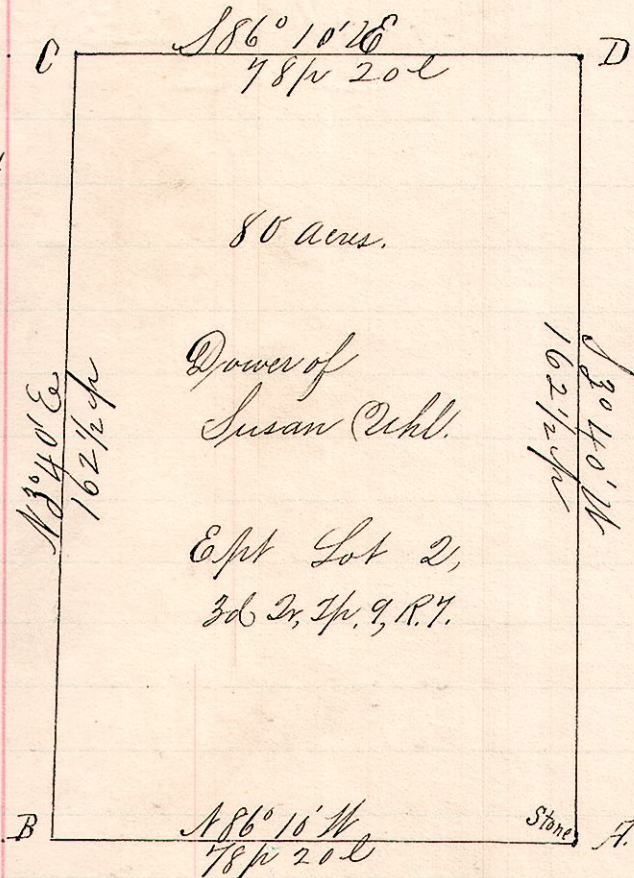

Notes:  
 A, a stone at the southeast corner of Lot 2, of the 3d quarter 7th, of 7th, 9, R. 7.  
 B, a post on south line, N 86° 10' W 78 p 20 l.  
 C, a post on north line N 3° 45' E 162 1/2 p from B.  
 D, the northeast corner said Lot is S 86° 10' E 78 p 20 l from C and N 3° 10' E 162 perches 13 links from A.

Dower of Susan Uhl, Widow of G. W. Uhl, deceased.  
 Surveyed for David M. Bilderbach and Cyrus Uhl, Administrators. Nov. 23, 1892.

Frank H. Gunt,  
Co. Surveyor,  
Hobbes Co. Ohio.