

No. 463.

Legal Survey Notice.

To Victor Besancous, Joseph Walter Kiss, Henry Walter, H. C. Barnes, James Ross, Jonathan Phillips, Susan Phillips

R 7 1/2 Sec 27 and 28
12 15 34 - 33

You are hereby notified that a survey will be made and testimony taken by the County Surveyor of Holmes County, Ohio, on the 5th day of January 1893, between the hours of 10 A.M. and 4 P.M. and to continue from time to time at the request of said County Surveyor until the lines, boundaries and corners of the following described tract of land, now owned and held by H. C. Barnes, et al, and situate in Sattercuk township, Holmes County, Ohio, can be established:

Being pt of the S.E. Quarter Sec. 28, Tp. 15, R. 12.

Interested parties are hereby notified to give said Surveyor the names of witnesses they wish subpoenaed and to be present at said survey.

Signed this 10th day of Dec. 1892.

Amos C. Stucker.

The State of Ohio, Holmes County, So.

Amos C. Stucker being first duly sworn states that on the 10 day of Dec. 1892, and at least 20 days before the 5th day of January, 1893, he served copies of the foregoing notice on each of the parties named therein.

(Signed)


A. C. Stucker.

Sworn to and subscribed in my presence this 24th day of Jan. 1893,

Frank H. Gunt

County Surveyor

On the 5th day of January 1893, I proceeded to the premises to make said survey. Owing to the disagreeable weather we postponed the work till Jan. 10, 1893, and again postponed till Jan. 24, 1893 for the same reason. Began the Survey on Jan 24, 1893, by selecting as Chairman Warner Spencer Samuel B. Spencer, as Writers, Victor Gunt and John Holgamot, all sworn.

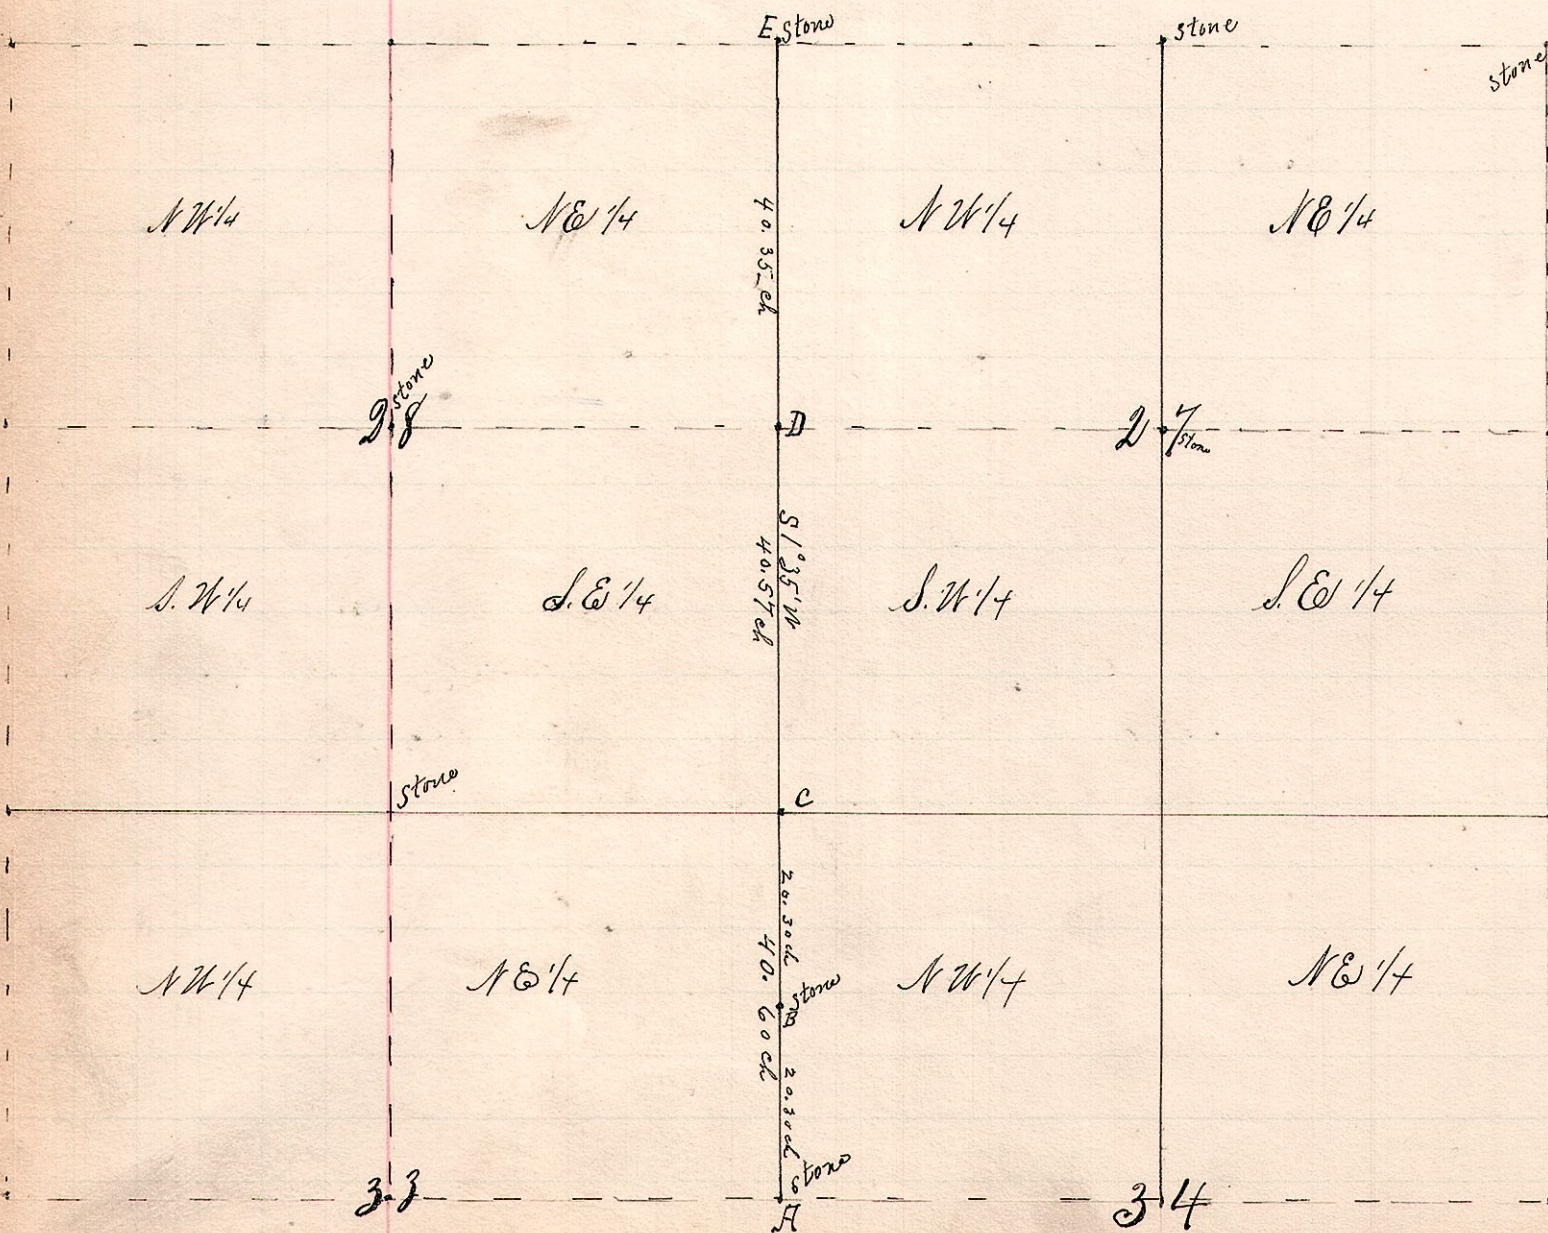

Notes

The corners C and D the southeast and north-east corners of the southeast quarter of section 28 Tp 15 R 12 the same were established by note from a survey of Samuel Robinson in 1861. B, a stone in School lot is half way between A and C, the southeast and north east corners of the NE 1/4. In section 33 Tp 15 R 12, E, a stone on County Line At C and D, we planted good stone corners, the original witnesses were gone.