No. 496.

Legal Survey. Notice.

To Ida Yocum

You are hereby notified that a survey will be made and testimony taken by the County Surveyor of Holmes County, Ohio. on the 20th day of April 1893, between the hours of 8 A.M. and 4 P.M. and to continue from time to time at the request of said County Surveyor until the lines, boundaries, and corners of the following described tract of land, now owned and held by Ida Yocum and William Gilson and situate in Ripley township, Holmes county, Ohio, can be established:

Being the line between the southwest quarter of Section 12, Tp. 17, R. 14, and the southeast quarter of Sec. 11, Tp. 17, R. 14.

Interested parties are hereby notified to give said Surveyor the names of witnesses they wish Subpoenaed and to be present at said Survey.

Signed this 17th day of April 1893.

William Gilson.

State of Ohio Holmes Co, SS.

William Gilson, being first duly sworn states that on April 17, 1893, he served a copy of the above notice on Ida Yocum.

William Gilson.

Sworn to and subscribed in my presence this 20th day of April 1893.

Frank H Genet
C. Surveyor.

On the 20th April 1893, began survey at the southeast corner of W pt S W 2r Sec 12 Tp 17 R 14, at a stone we supposed to be the true corner.

Finding none of the original witnes trees we took the following new witnesses to said corner; Gum 12 S 80 W 21 links, W oak 16 N 43 W 60 and Hickory 4 N 1° E 33 links

Thence N 1° 10' E 160 p & l to a Stone at northeast corner said W pt of South West Quarter,

A Stone 48 rods south of said Northeast corner is 8 links west of said line. Stump of tree 21 perches North of said stone mostly on east side line.

R Tp Sec Dr
14 17 12 SW

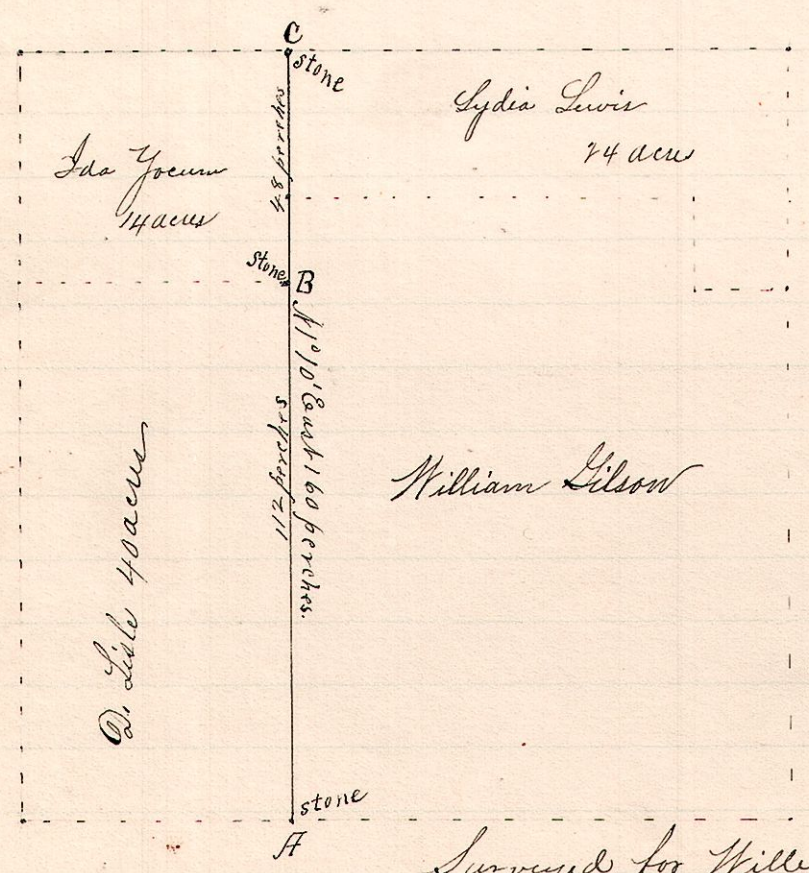

Notes

"A," stone at southeast corner W. pt. S.W. 2r. Sec. 12, Tp. 17, R. 14. witnessed by a Hickory 4 N 1° E 33 l and Gum 12 S 80° W 21 links, also W oak 4 N 43 W 60 l

"B," stone 8 links west of line running N 1° 10' E 112 perches from "A."

"C," stone on North line said Quarter N 1° 10' E 160 perches from A.

Surveyed for William Gilson, Ida Yocum, et al,

April 20, 1893.

Frank H. Genet,
County Surveyor.