


No. 516.

R 7 S 2
7 8 2 SW 1/4

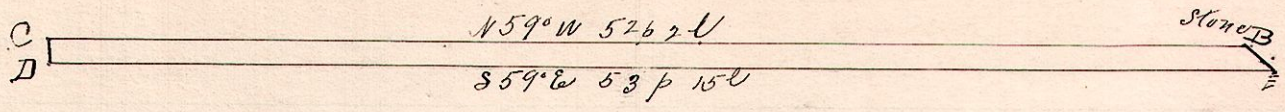

Notes.


- "A", a stone at the southeast corner of the southwest qr. Sec. 7, Tp. 8, R. 7.
- "B", a stone on the east line of said quarter N 3 1/2° E 67 p 10 l from A.
- "C", a stone in the Millsburg & Hillbuck road N 59° W 52 p 2 l from B.
- "D", a post in said road S 14° E 16 feet from C.
- "E", a post on east line said quarter S 39° E 53 p 15 l from D, and 30 feet S 3 1/2° W from B.

Surveyed the above private road sold to Mrs. Jane Guj by Mrs. Ann Leiger. Sept. 4, 1893. Chainmen Geo. Ryan and Al. Ralston.

Frank N. Gault,
County Surveyor

No. 517.

R 7 S 2
8 9 4th 23
SR 60

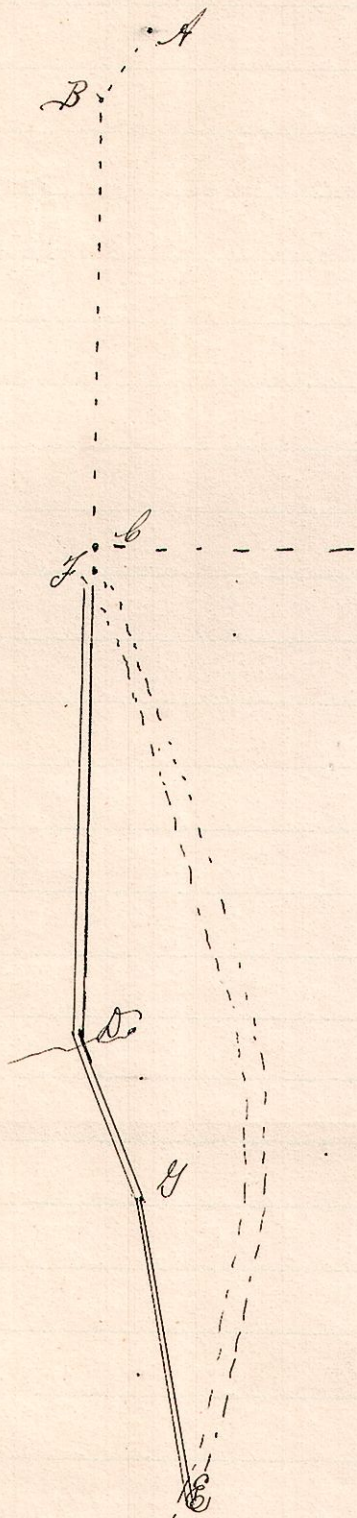

Notes.

- "A", is a stone at the northwest corner of Lot Number Twentythree (23) of the Fourth Quarter Township of Tp. 9, R. 8.
 - "B", a post in public road from Welcome to Hillbuck, S 3 1/2° W 7 p. 9 l. from A.
 - "C", north side said road S 36 1/2° E 26 p 14 l from B.
 - "F", a post in said road S 35 1/2° E 1 p 6 l " C.
 - "D", a post near J. I. Korns house S 35 1/2° E 22 p 14 l from F.
 - "G", a post near barn S 58° E 9 p 10 l from D.
 - "E", a post in old road, the terminus of proposed alteration S 48° E 19 p 8 l from G.
- The dotted lines from C to F represents the old road.
Established new road 40 feet wide

Viewers
M. C. Lieb
Henry Kasper
O. Shrimplin.

Principal Petitioner
J. I. Korns.

The above is a correct plat and notes of an alteration of a county road, as viewed and surveyed Sept. 17, 1893.

Frank N. Gault,
County Surveyor