


R T S  
14 17 15  
Ripley

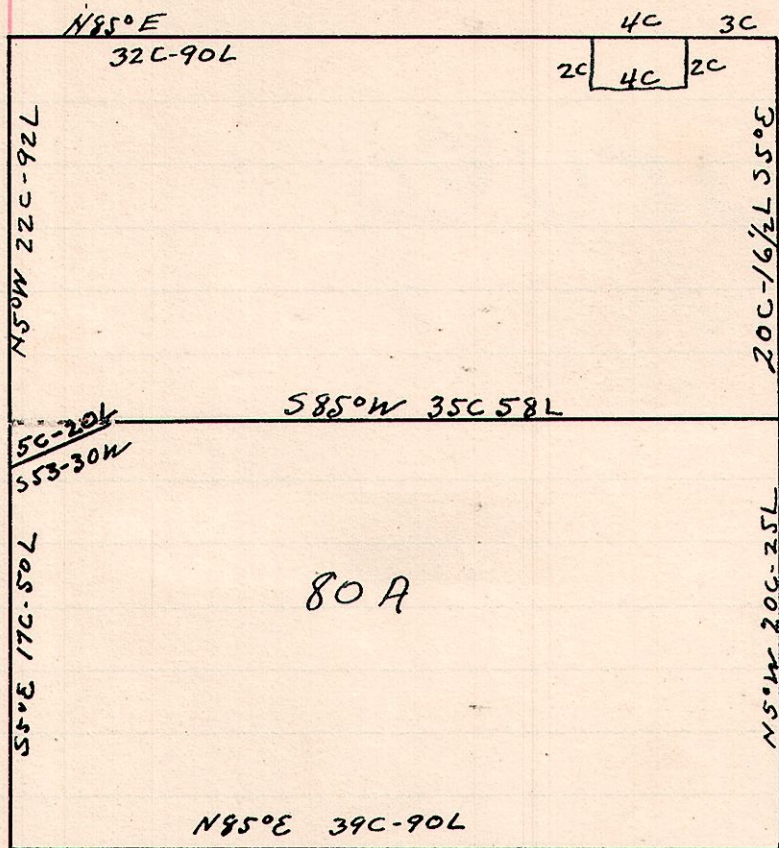

I hereby certify this to be a true copy of the survey as surveyed by me Oct 1942  
Karl Snyder  
County Engineer

R T S  
14 17 22  
Monroe Twp

