


Sec 5. T¹⁴. R 11.

full N&E Run 8.
W. Oak 15 S 76° E. 29.
Chestnut 36 S 63 W 35.
323.12.

11.14.5.

No 14.

323 12 / 161 18

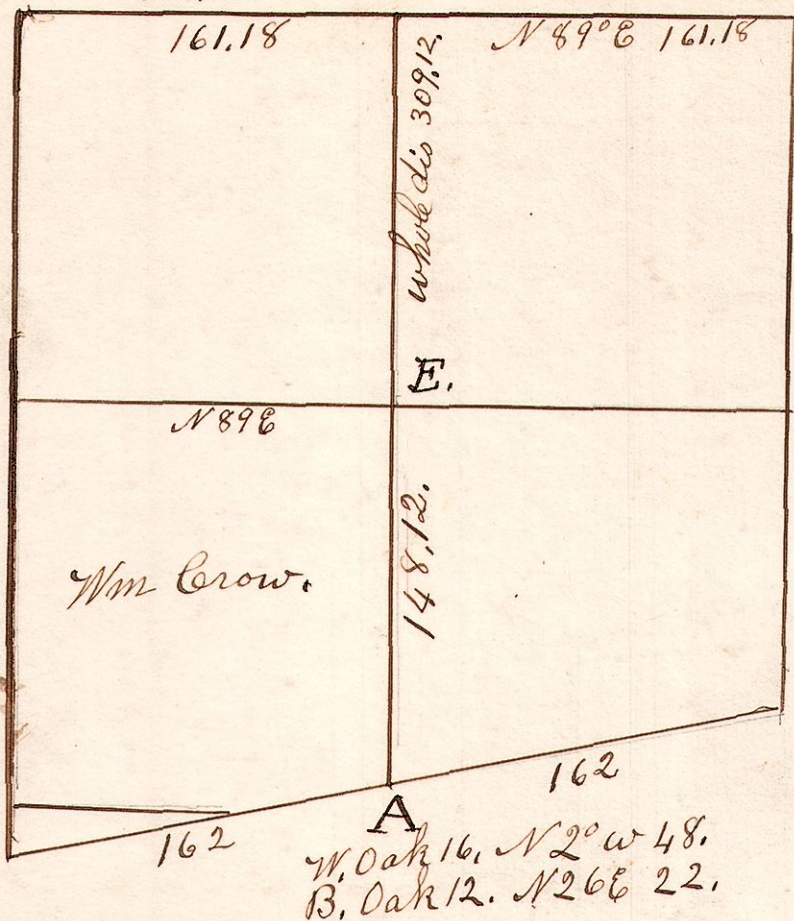


11.15.35.

No 16

March 19th 1857.

S w q^r Sec 35. T¹⁵. R 11.

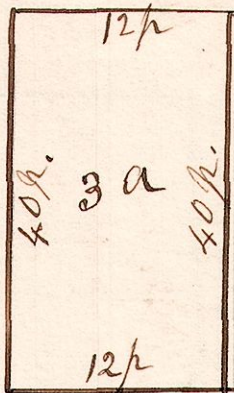

Break New corner.

S.W. corner

November 13th 1829. Surveyed Section No 28 in Township 15 of Range 11, in the following manner & for the following persons.

Sugar 15. S 26 67.


11.15.28.

No 15.

Post, G

Hickory D
5 the corner

C&W line 325.6. N 2° 30'.

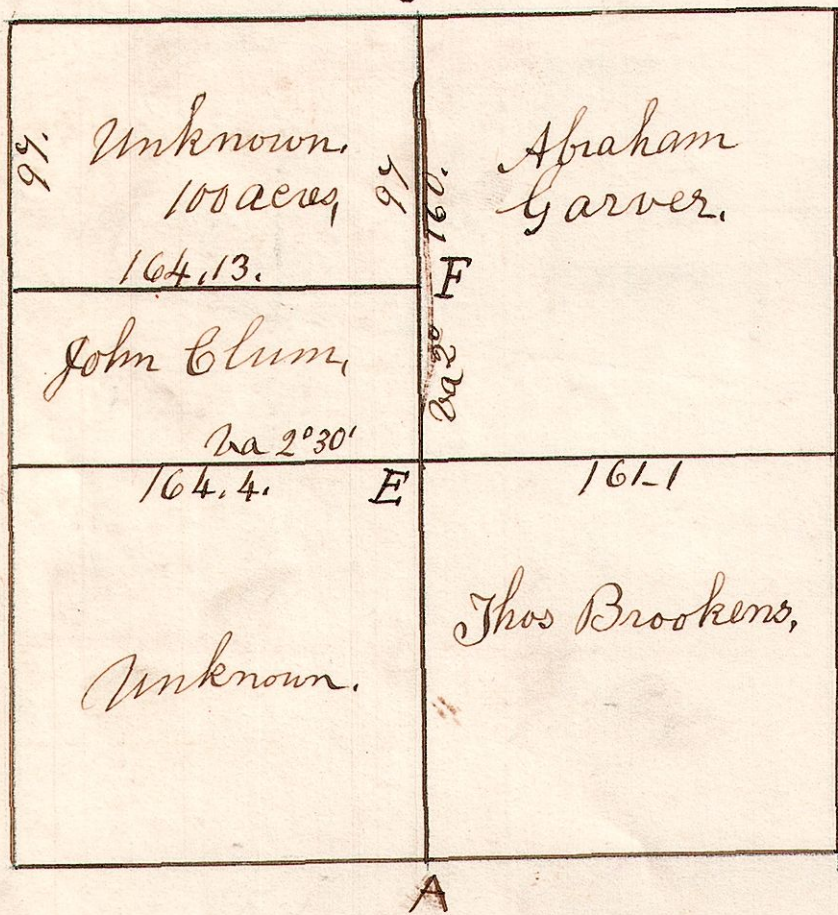

C
Maple 13. N 50 W 13.
" 12. S 51 E 12.

E. W. Oak 15 S 63 W 22. Hickory 15. N 55 E. 14.
" do . 15 N 31 W 47. Maple 12. S 64 W. 25.