


4.9.5.

No 54.

June 12th 1831. Surveyed Section No 5 in Township 9 of Range 4 in the following manner, and for the following persons, Indian Trail creek.

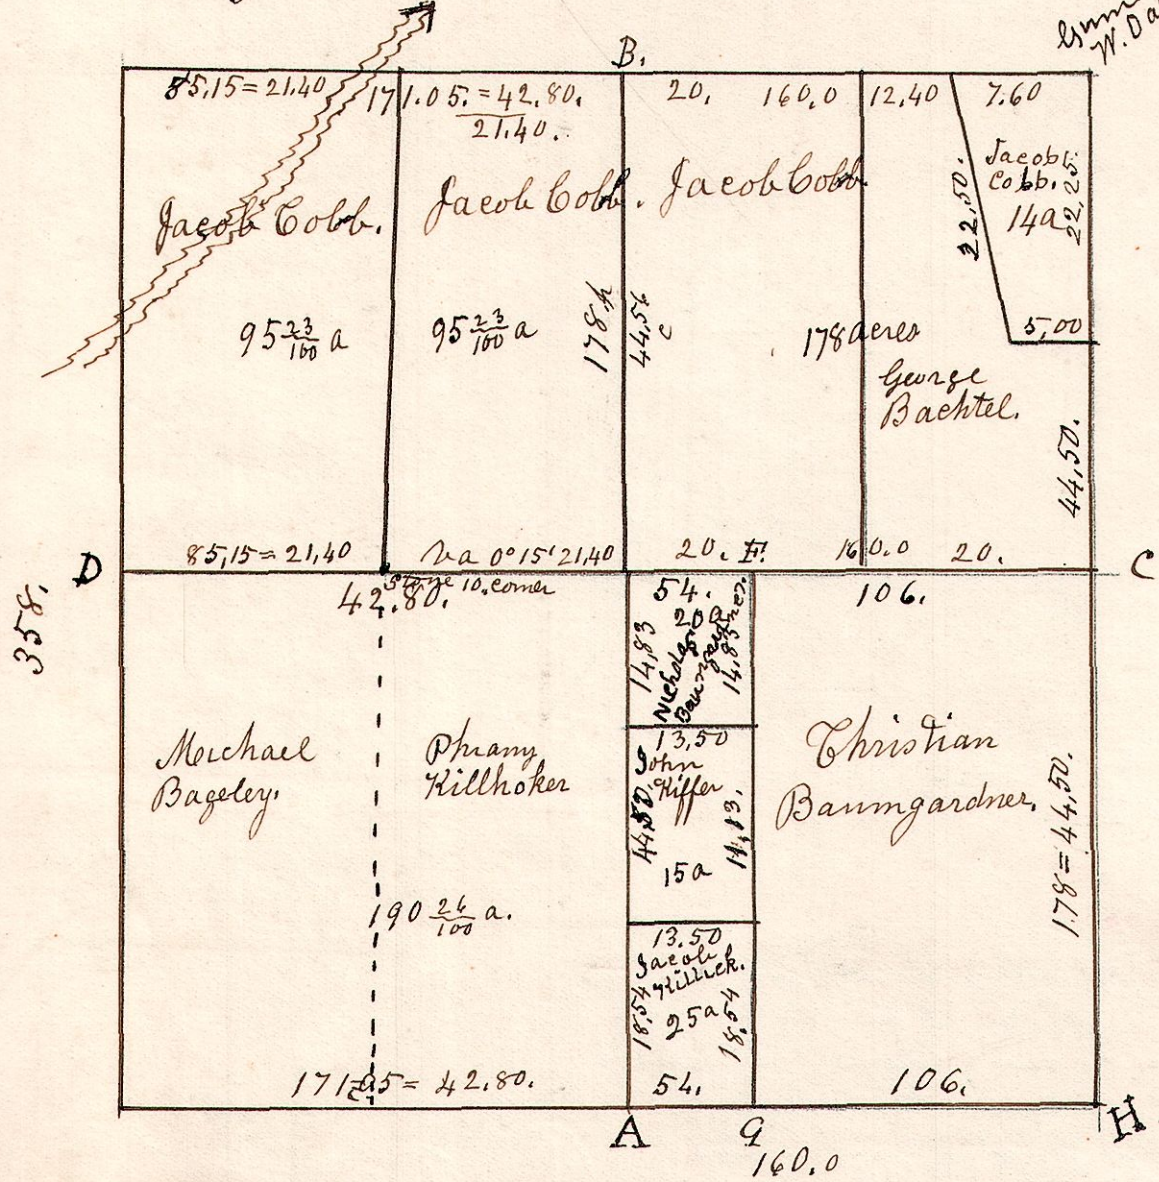


A.	12	N 9 W	27.	W. Oak,
"	13	S 59 W	23	do
B.	30	D 82 E	19	W. Oak,
"	20	N 51 W	41	do
C	6	S 53 E	12	Dogwood
"	15	N 38 W	29	Maple
D.	40	N 41 W	10	Chestnut
"	16	S 18 E	37.	Hickory
E	16	N 12 E	12.	Chestnut
"	12	S 26 W	20 1/2	W Oak.

4.9.4.

No 55.

NW qr of Sec 4 T9 R 4. The wpt formerly belonged to David Selbright.

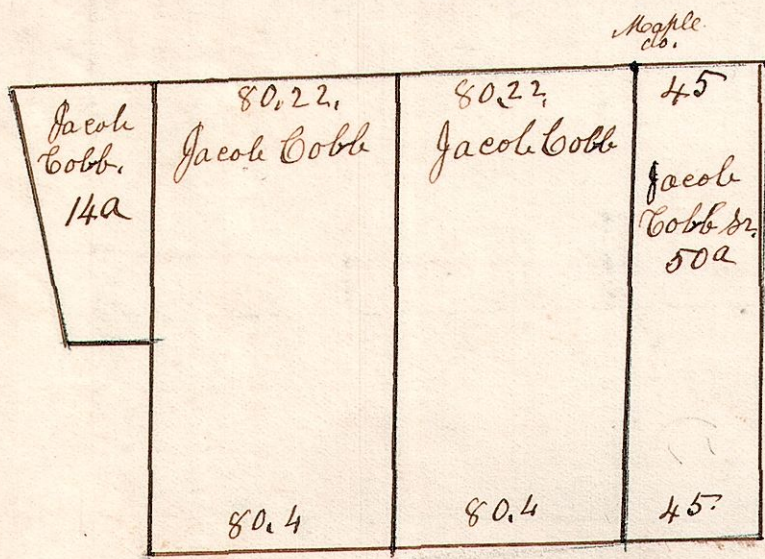

also Surveyed 50 acres for taken off of the w side of the NE qr of Sect. 4, T9, R 4. January 3rd 1833. Deed to be written for 50 acres from Joseph Landis and Catharine Landis his wife, to Jacob Rulph, sen, 5 acres wpt of NE qr of Sec 4, T9 R 4. for the sum of 25 dollars