



5.9.22.46

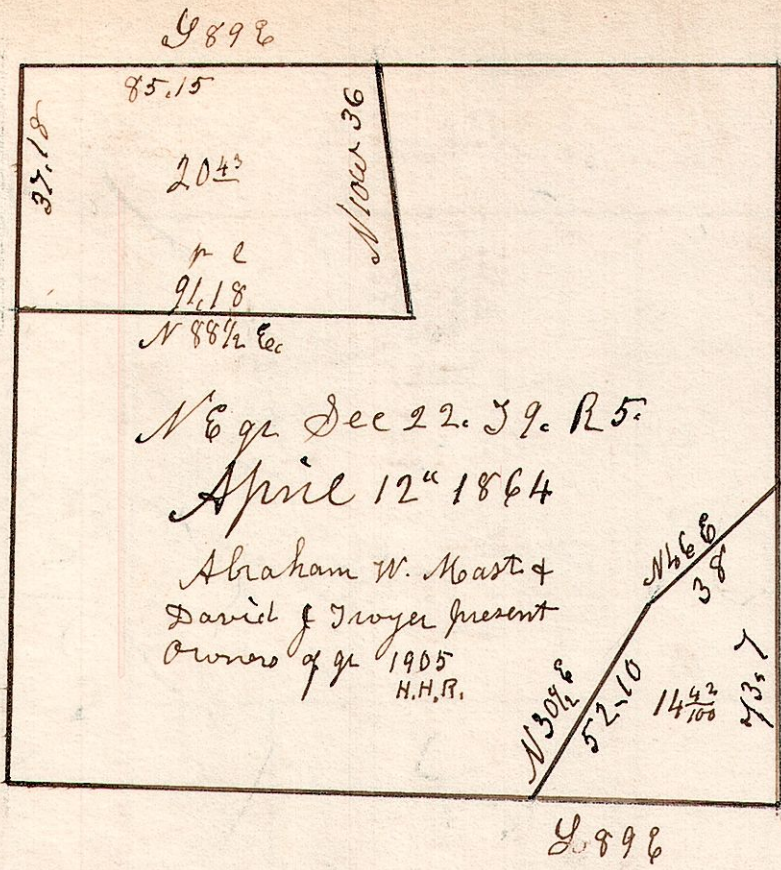

5.10.21.39

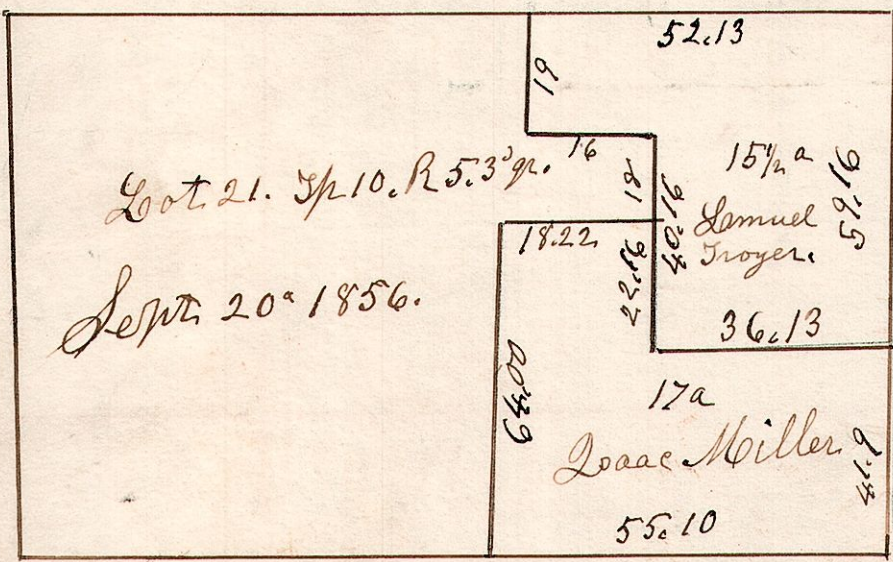


5.10.17+19.39

Sept 20 1856


pt of lot 17 & 19. Sp 10. R 5. 3 1/2 gr.

N 89 1/2 E 109

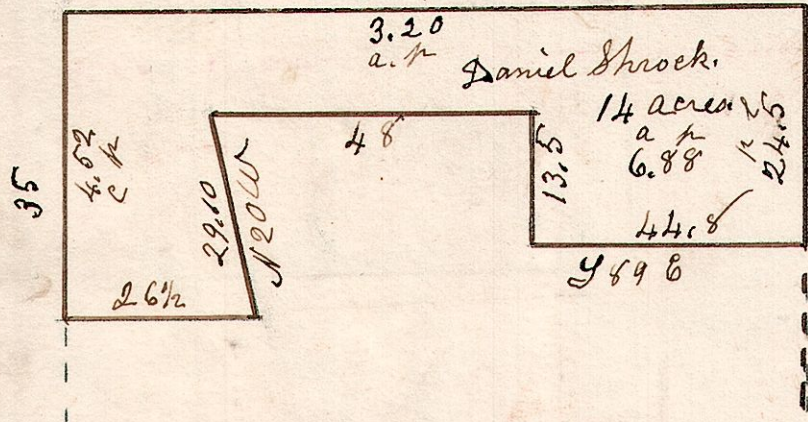

5.10.13.39

December 31st 1834, Surveyed lot 13 in Sp 10 R 5. 3 1/2 gr. for G. Swinehart.

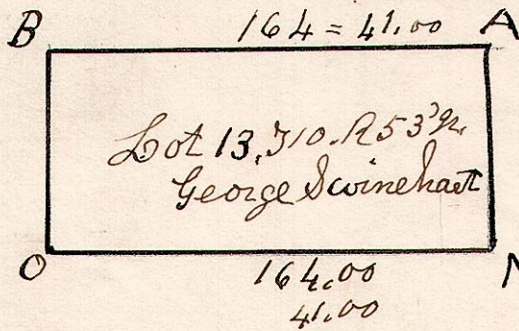

A	Cum	12	N 60 E	28
	Hickory	12	S 48 W	16
B	W Oak	20	West	5
	Beech	12	N 61 E	14
O	Hickory	12	N 30 E	17
	W Oak	15	S 55 W	8
N	W Oak	20	S 18 E	32
	do	25	N 52 W	15