72

5. 9. 20/21.

Nov 20th 1855

No 169

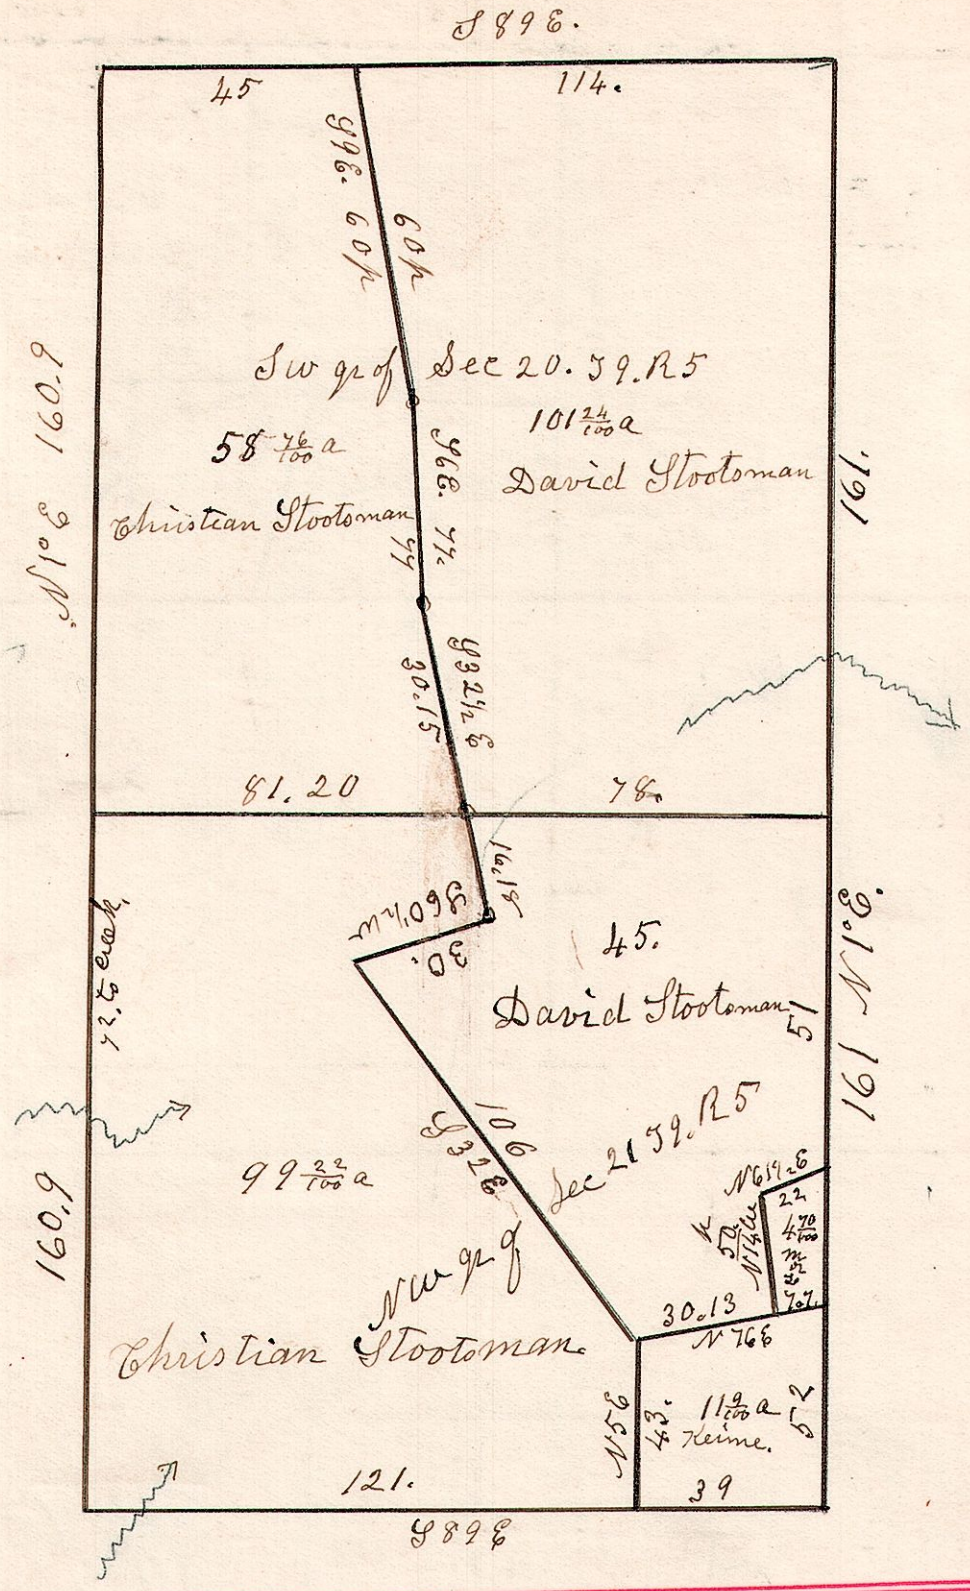

5. 9. 20. Wpt. N.W.

May 11th 1826.

No 170

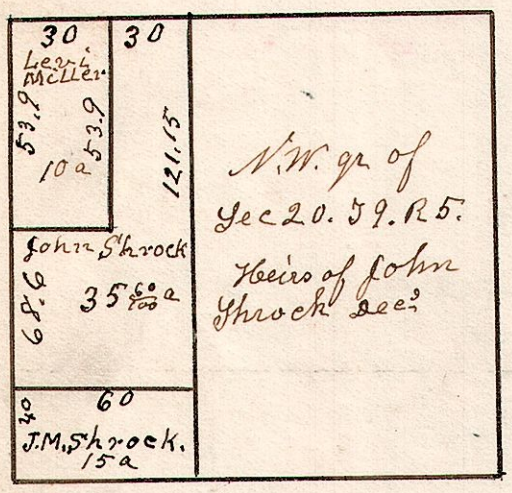

5. 9. 19.

Sec 19. T9. R5

May 26th 1826.

No 172

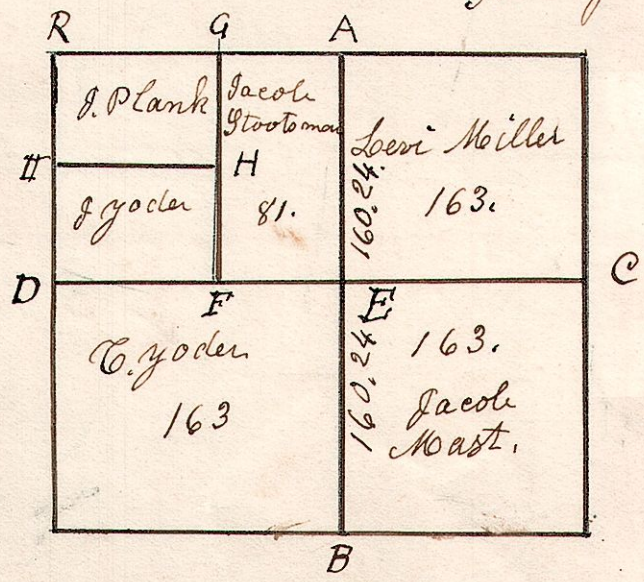

A	W. Oak	18	N 55 E	15		C	W Oak	18	S 81 W 7
"	do	24	S 46 E	36		"	Sarvice	5	N 39½ E 4
E	W. Oak	20	N 56 E	25		H	W Oak	25	N 75 W 8
"	do	23	S 52 W	36		"	do	30	S 70 E 23
F	W. Oak	40	S 84 W	23		II	W Oak	14	N 16 W 7
"	Dogwood	12	S 75 E	17		"	do	12	S 80 E 41
G	W. Oak	22	S 36 E	27		B	W. Oak	26	S 32 E 20
"	Thorn	4	S 81½ E	22		"	do	28	N 50 E 28
R	W. Oak	12	S 23 W	8		D	W. Oak	15	N 61 E 7
"	Hickory	13	N 17 E	30		"	Hickory	0	S 30 W 25

Surveyed May 12th 1826.