5.8.22. NW qr Sec 22 T8. R5.

S 89 E

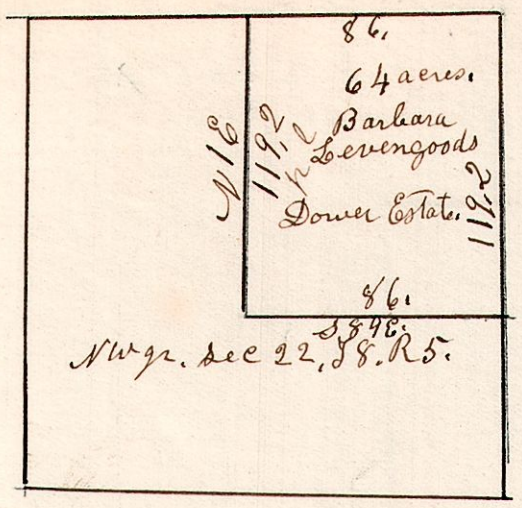

June 29th 1848.
Jacob Fisher, Wm Farver, Joseph Deal } Commissioners.
Petition for Dower

5.8.22.

N.E. qr. Sec 22. T8. R5.
Surveyed the above. Feb 22d 1850.

S 89 E. Dower estate Feb 22d 1850.
for Catharine Row, Widow of Geo Row dec.

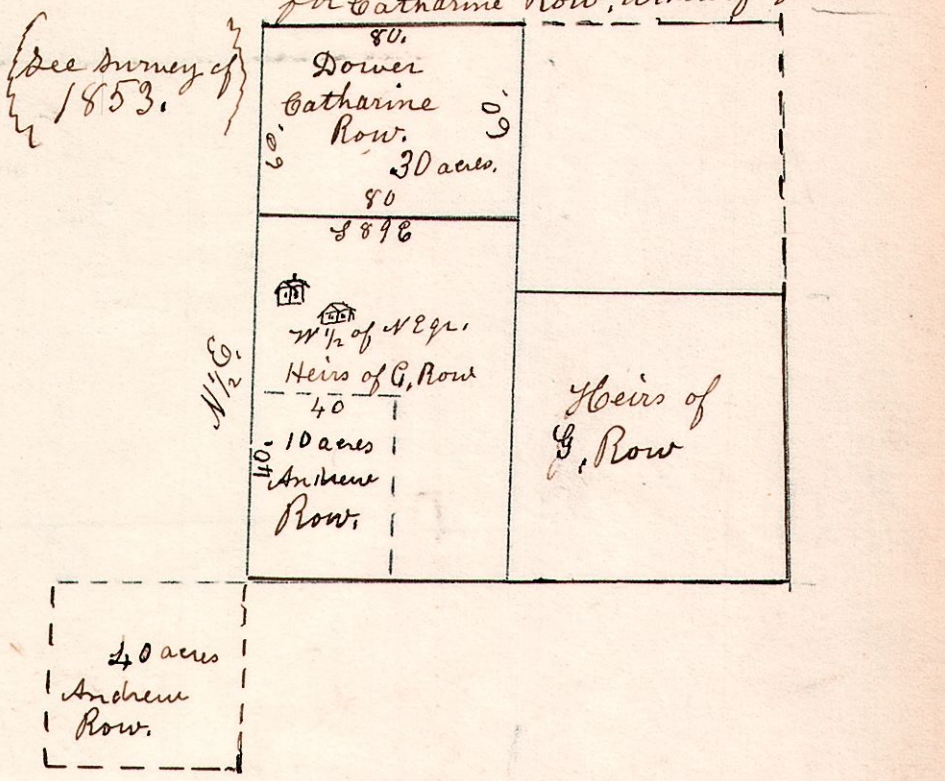

5.8.14. June 1st 1832. Surveyed Section 14 in T8 of R5. in the following manner, and for the following persons.

B. Oak 24 S 18 W 54.
do 24 N 29 E 45.

Chestnut 24 N 16 W 40.
B. Oak 18 N 30 E 29.

W Oak 20 S 50 E. 4.

W. Oak 18 N 21 E 85.
B. Oak 25 S 21 W 68.

Ash 15 S 78 W 3.
do 9 S 55 E 28.

Hickory 12. N 43 E. 34.
W. Oak 8. N 63 W 28.

W. Oak 24 N 56 W 6.
do 14 S 37½ E 22.

W. Oak 15 N 21 W 45.
Elm 15 S 74 E 45.

N & S 323.8

E	Stone	12"	the	Corner.
F	W. Oak	30	N 34 W	32
"	do	20	S 44 E	6
G	Stone	10	the	Corner.

5.8.14.
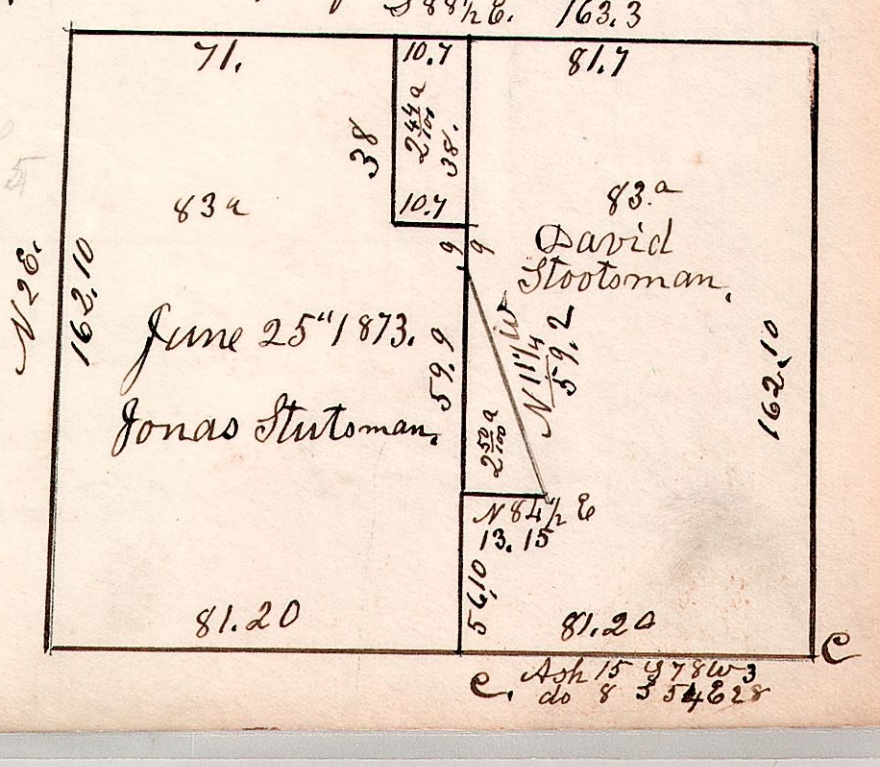
N.E. qr of Sec 14. T8. R5.
S 88½ E. 163.3