

November 25 1826.


15.19.2. Surveyed Section 2 in T19. R15 in the following manner.

B Oak 9 N39W 68.  
W. Oak 10 S33E 22.

W Oak 20 N20W 16.  
do 16 S49E 32.

W. Oak 7 S82E 38.  
do 5 S7W 28.

C	W. Oak	40	N51W	30
"	do	18	S55W	30
B	B. Oak	5	S80E	35
"	do	4	N15E	67
K	W. Oak	10	S22E	63
"	B. Oak	8	N8W	44
I	Hickory	12	S12E	48
"	do	10	S82W	21
L	Dogwood	6	N4E	11
"	W Oak	24	S73E	33

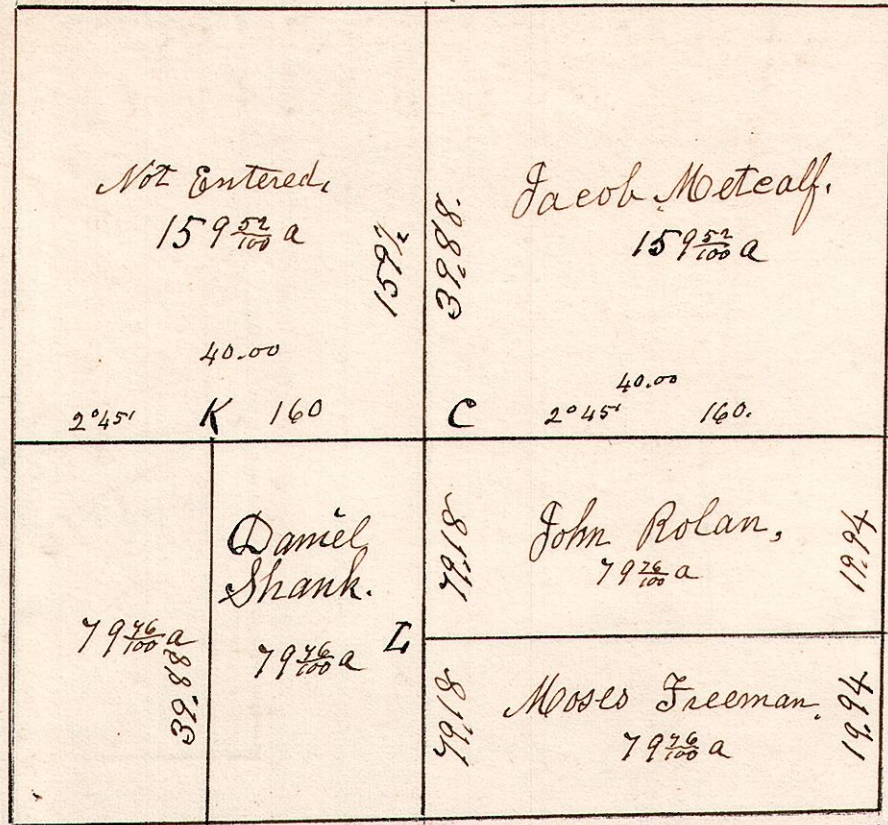

W Oak 18 S17W 16.  
B. Oak 16 N11E 11.

Pine 10 S17W 14.  
" 12 N23W 17.


W. Oak 10 S20E 30.  
B. Oak 20 " 14

W. Oak 18 N12W 38.  
do 12 N63E 52.

W oak 36 N45E 39.  
Ironwood 6 N73W 34.

15.19.16. February 22 1832. Surveyed Section 16, T19, R15. In the following manner for the following persons.

W. Oak 15 N28W 25. Stone 12 the corner.  
do 20 S25E 23.

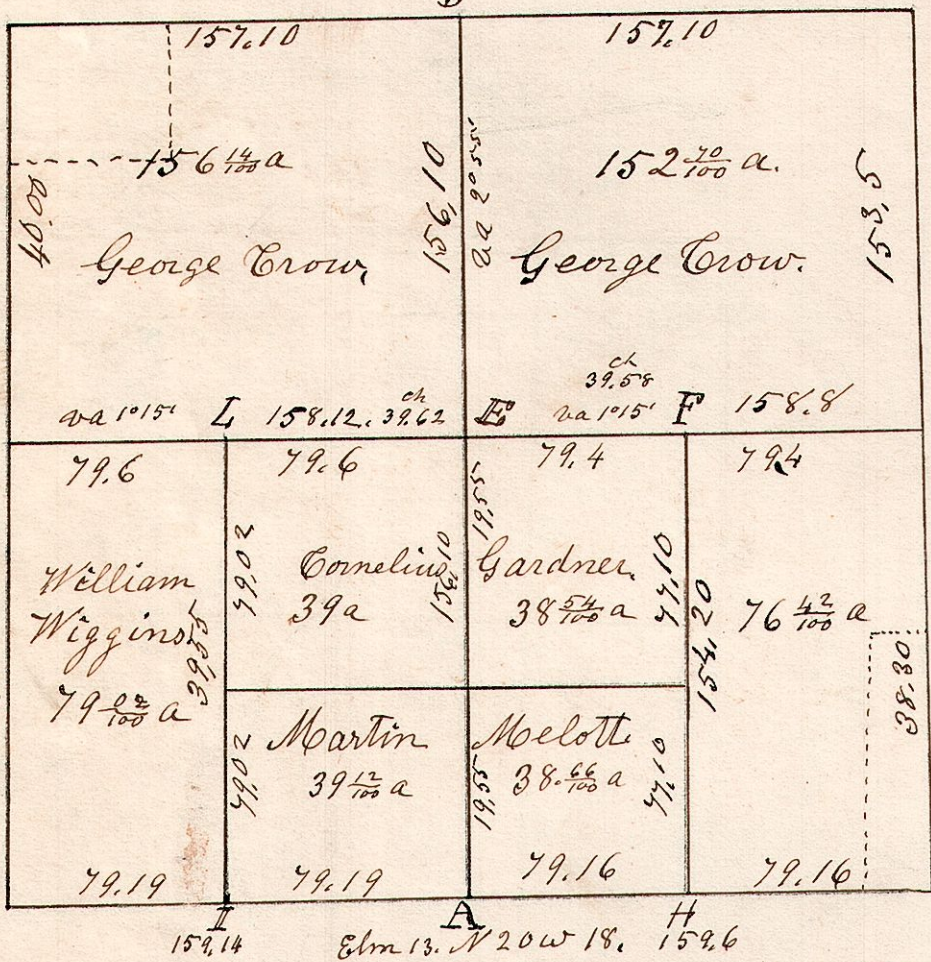

F	Stone	15	corner.
F	W. Oak	24	S80E 29
"	do	20	West 25
G	W. Oak	36	N3W 3
"	Hickory	12	S45E 16
H	W. Oak	12	East 34
"	do	12	N52W 10
I	Hickory	20	S73W 3 1/2
"	Sugar	4	S62E 34
K	Hickory	12	S21E 16
"	Ash	4	S67W 29
L	Elm	9	N65E 22
"	Dogwood	6	N21W 22

See 20 acres too small.

15.20.34 November 10 1825 Surveyed 60 acres of the N.W. q. of Sec 34 T20. R15. beginning 104 perches from the S.W. corner of said section on the west side in the center of Mohegan creek; thence S29°30' East 104 perches to a stake; thence N87°30' E. 100.2 perches to a stake; thence N19°30' W 108 perches to the center of the abscant Creek; thence along the center of the creek to the place of beginning. Containing 60 acres.

