


7.9.19.

Surveyed the above May 3rd 1826.
Being Section No. 19. in Township 9 of Range 7.
of which the above is a correct plat.

Samuel Robinson
Co Surveyor.

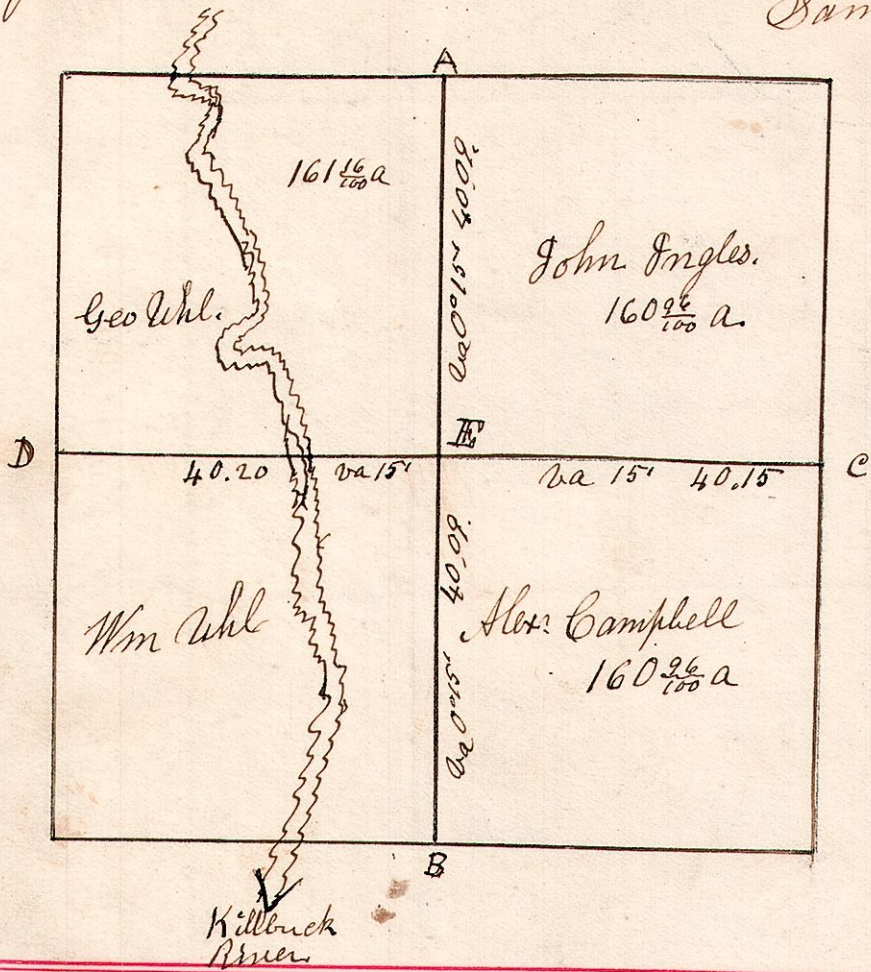

A	Beech	12	N 47 W	15
"	Elm	12	N 70 E	13
B	Beech	12	N 78 W	28
"	do	12	N 83 E	28
C	Sugar	18	N 3 W	15
"	Dogwood	6	N 7 E	25
D	Sugar	12	N 62 1/2 W	4
"	do	15	N 9 1/2 W	29
E	Elm	20	S 4 E	24
"	Hickory	14	N 73 E	23



7.9.25th/₃₀ yr.

Lots 25th and 30th of 59. R 7.

7.9.29.

Lot 29 in 1st of 59. R 7. School Land.
Surveyed Sept 14th 1867 for
Joseph Adams.


Beech 14 1/2 14 1/2 20 C.

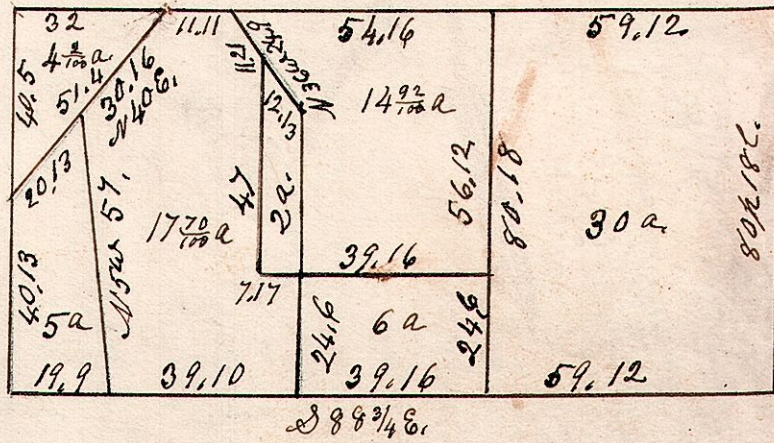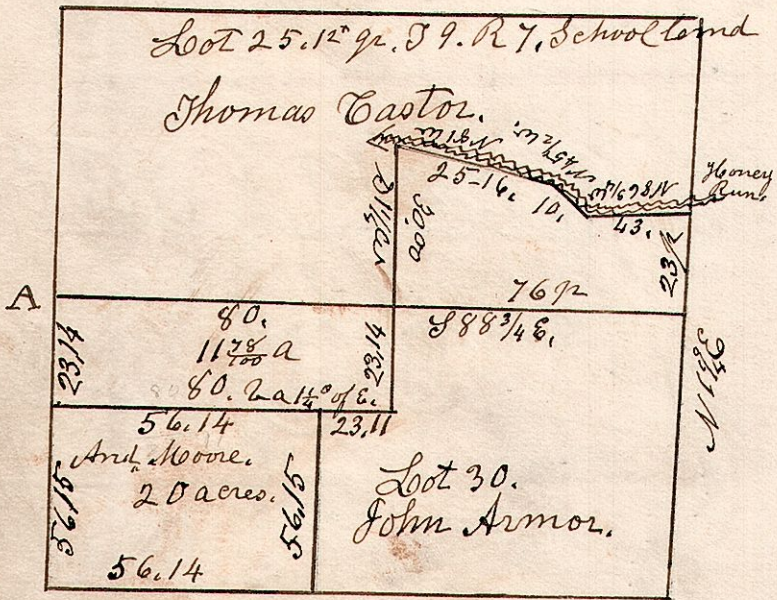

Surveyed March 5th 1848.

7.8.6

Section 6, T 8, R 7.

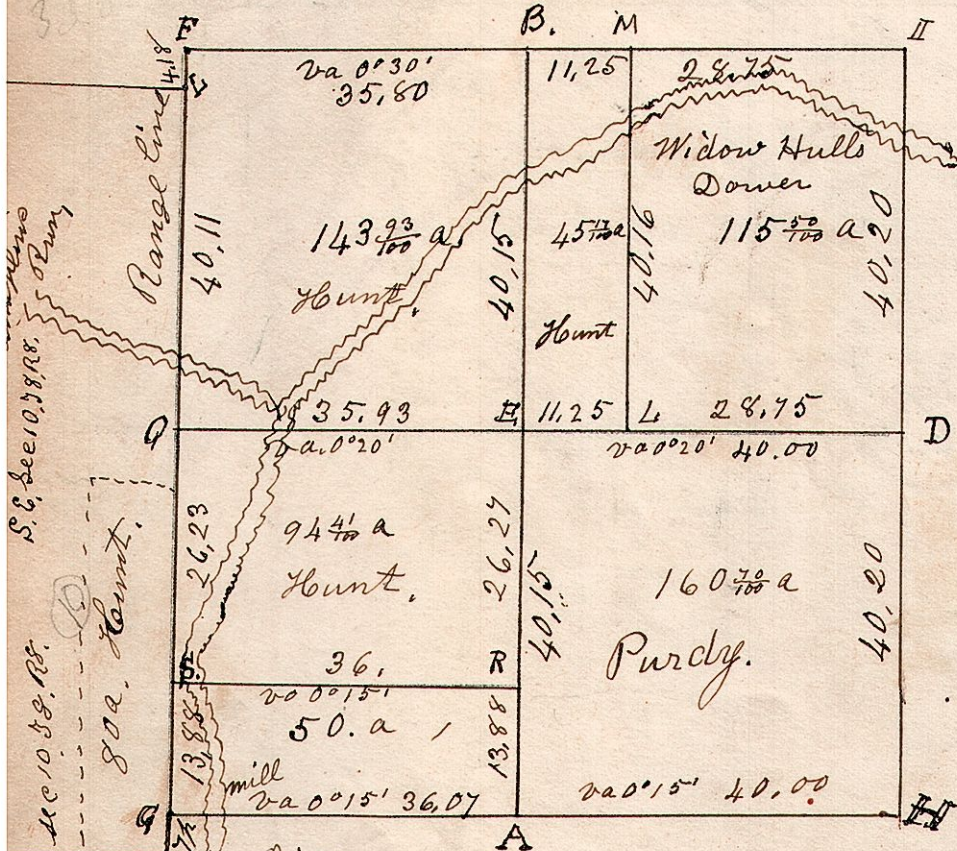

A	W. Oak	16	S 24 W	17
B	Beech	12	N 3 W	26
"	Maple	8	S 25 W	8
"	Elm	14	N 62 E	22
C	Sugar	22	S 74 W	11
"	Beech	15	S 72 E	25
D	W. Oak	20	S 27 W	25
"	Chestnut	15	N 84 E	13
E	W. Oak	20	N 11 E	29
"	do	18	S 67 E	8
F	Beech	18	S 50 1/2 E	50
"	do	12	N 39 1/2 E	42
G	Sugar	20	N 49 1/2 W	30
"	Elm	15	S 36 1/2 E	21
H	Beech	18	S 23 W	40
I	Elm	12	S 27 W	8
"	Beech	14	S 11 W	22
L	W. Oak	13	N 74 W	11
M	Maple	8	S 40 E	7
"	Elm	8	S 42 W	7
R	W. Oak	8	N 50 W	18
"	Hickory	8	S 22 W	11
S	Porton Bank of Creek.			

Surveyed the above Nov. 21st 1828.
Being Section Six in Township No Eight, of Range No Seven,
of which the above is a correct plat of the same by
Course and distance.

Samuel Robinson
Surveyor of Holmes Co O.

S. E. Sec 10, 38, 39, 40,100.

107 70