


A	Beech	12	N 71 E	6
"	do	10	S 54 W	9
B	Gum	20	S 37 W	38
"	W Oak	20	S 34 E	67
C	W. Elm	17	S 15 W	48 in swamp
"	do	15	S 20 E	60
D	W Oak	36	N 30 E	30
"	Beech	6	S 28 E	7
E	Stone corner in field.			



Surveyed the above January 27<sup>th</sup> 1827.  
Being Section 3. in Township 8<sup>th</sup> of Range 7.  
of which the above is a correct plat of the same  
Samuel Robinson  
Co. Surveyor.

7.8.3. x

Wm. Ling and Others  
March 1871.

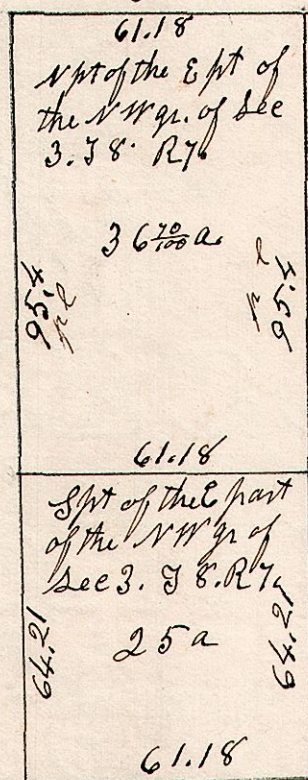


7.9, 25 1/2.

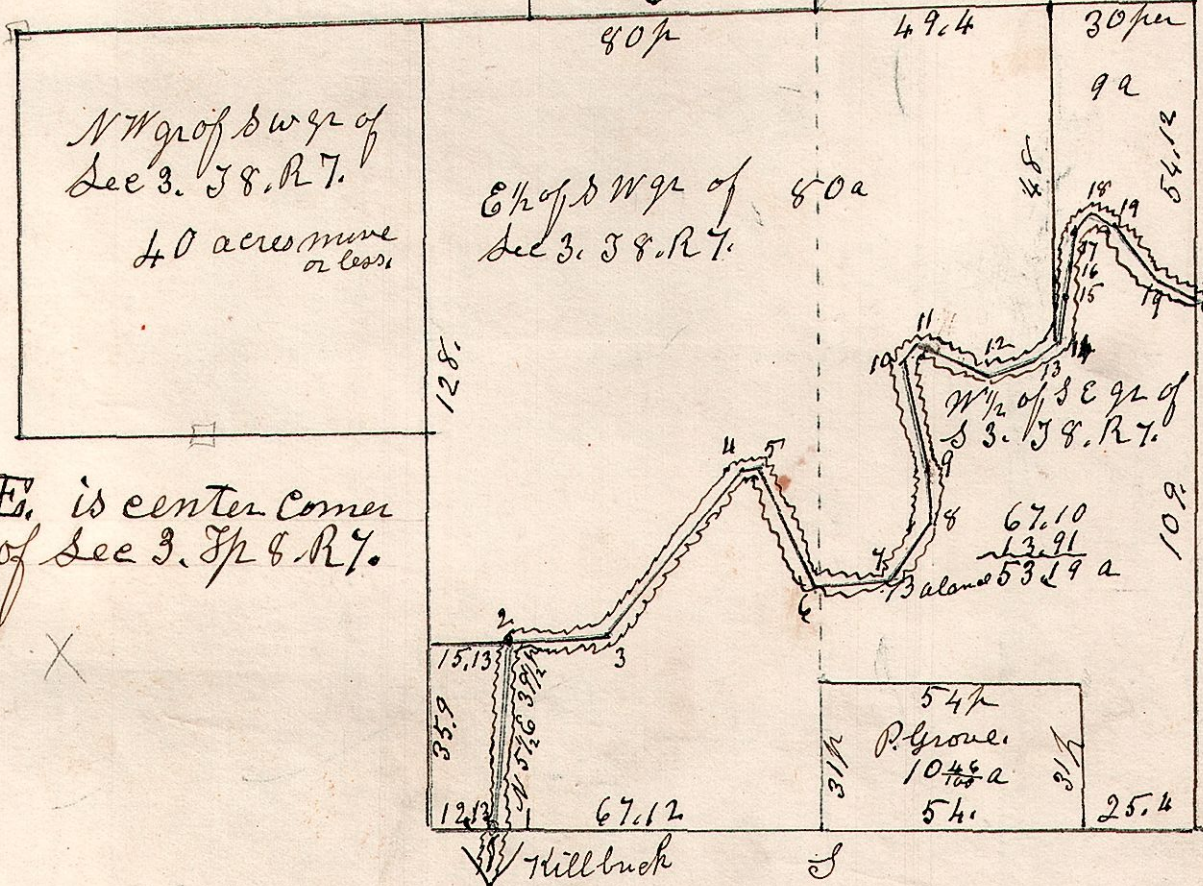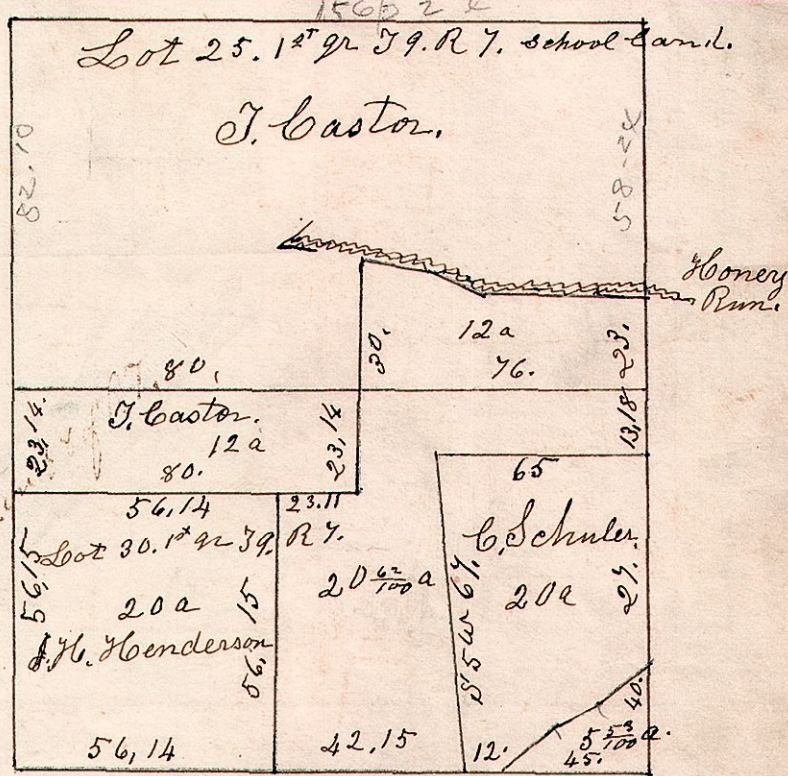

E. is center corner of Sec 3. T. 8. R. 7.

7.9, 18, 1828. See 18. T. 8. R. 7.

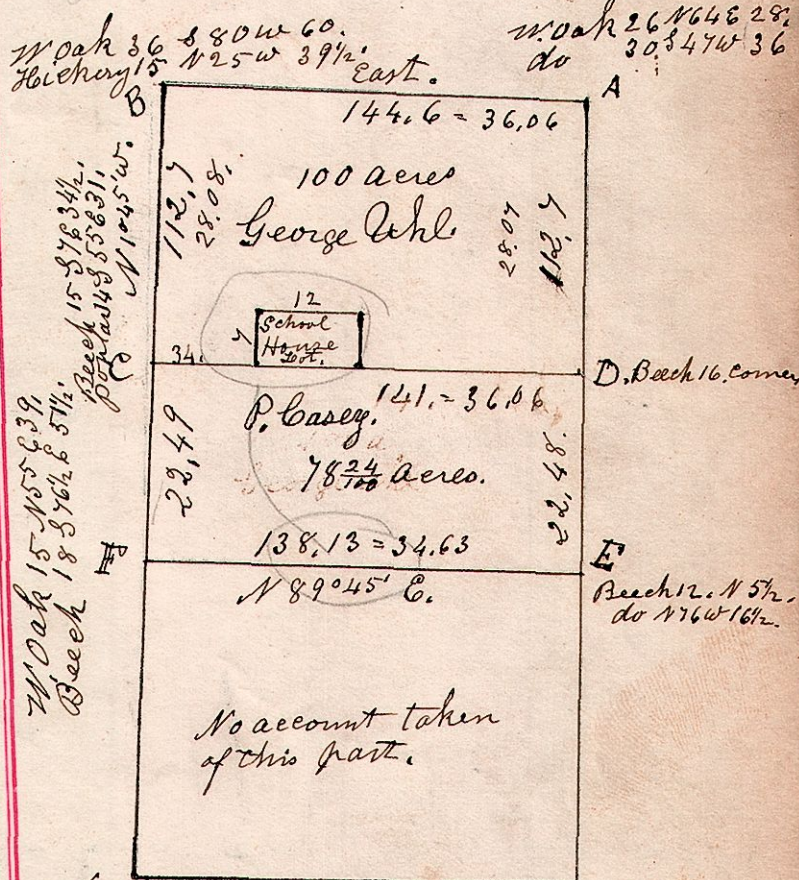


The above plat represents parts of Sec 3 in T. 8. of R. 7. Variation 1 1/2 to the right. S. Robinson Surveyor.

