12.14.2 August 25th 1855
Surveyed for John Painter.
S.E. qr of Section 2. T14. R12.

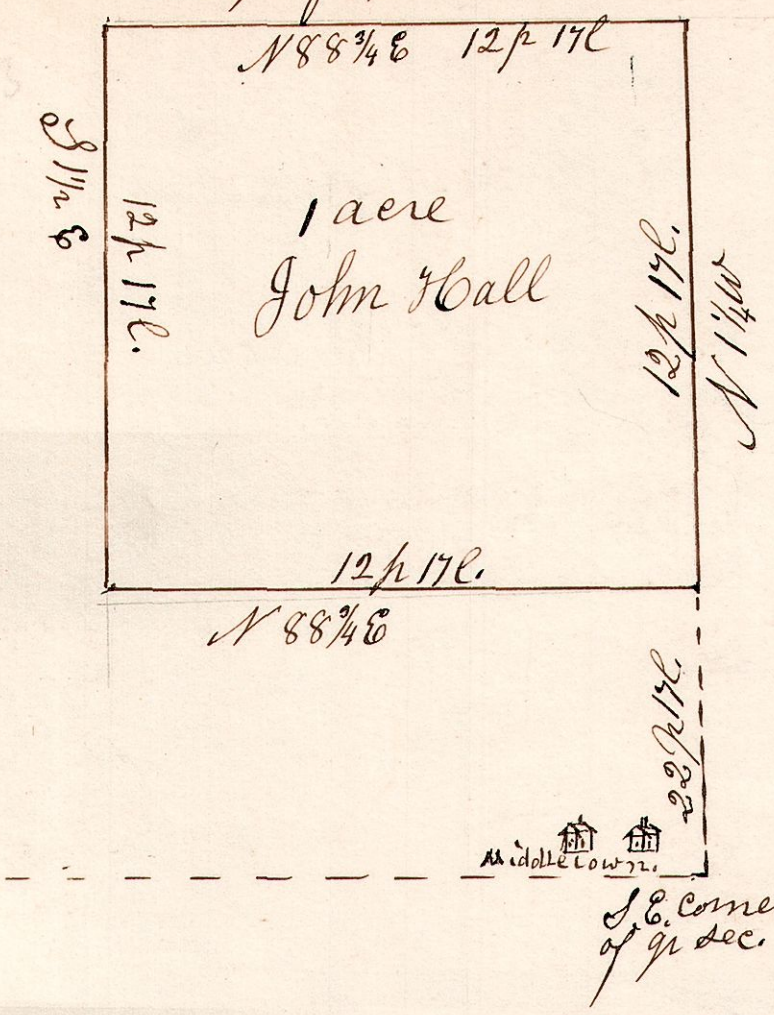

12.14.2 March 12th 1861.
J. Painters heirs. J.B. Painter adms.

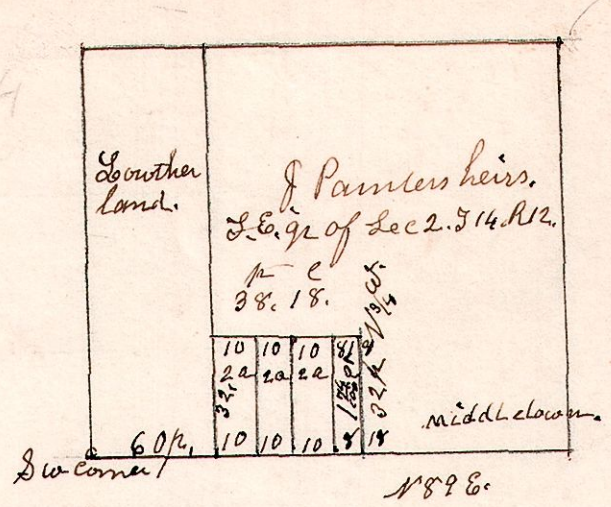

7.9.24. 2d qr. March 26th 1857.
Range 7. Township 9. lot 24, 2d quarter.

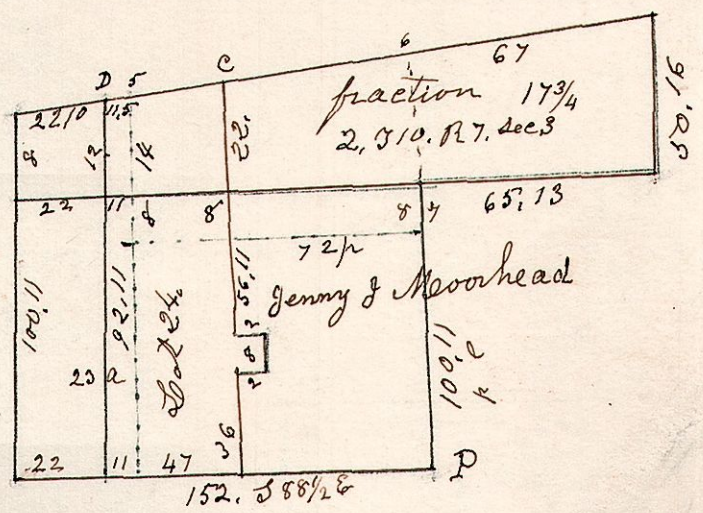

12.14.12. November 2d 1847.
J. Halls addition to Middletown.
Jackson Street 66 feet wide.

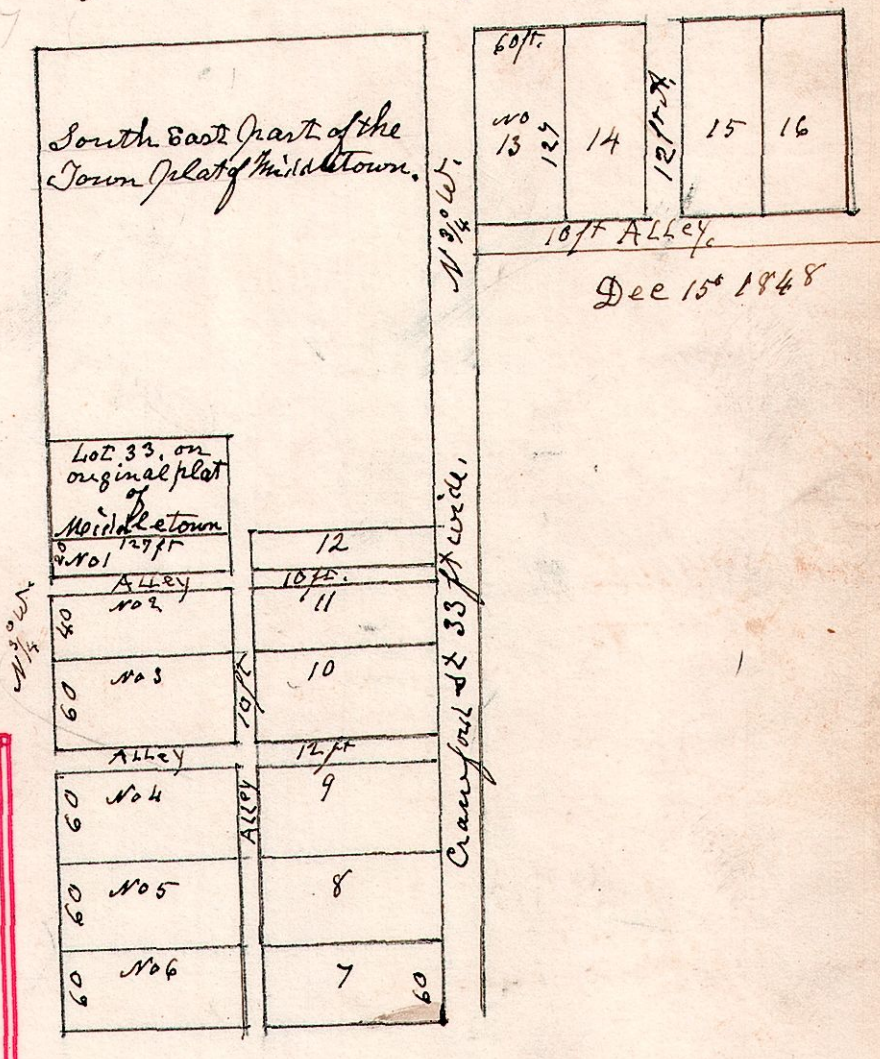

12.14.11. April 1st 1845.
N.E. Qrt. of Sec 11. in T 14. R 12.

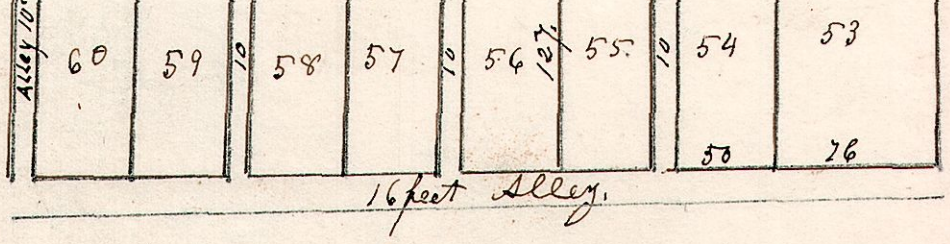

Josiah Shutts & George W Shutts Subdivision lots Situated on the N E part of S 11. T 14. R 12. Lot 53 is Situated 33 feet west of Lot No 24 of the original town plat of Middletown Holmes County Ohio.
Surveyed April 1st 1845. S. R. Surveyor.

The above plat represents Subdivision lots Situated on the north west part of Section 12. in Township fourteen of Range twelve, and adjoining the South East of the inlots in the original town plat of Middletown. Holmes County O.

Surveyed for John Hall
Nov 2d 1847 & Dec 15th 1848.
Samuel Robinson Surveyor.