


7. 9. 12.

April 27-1837.

Gen A. Johnson.


16 25
66.00

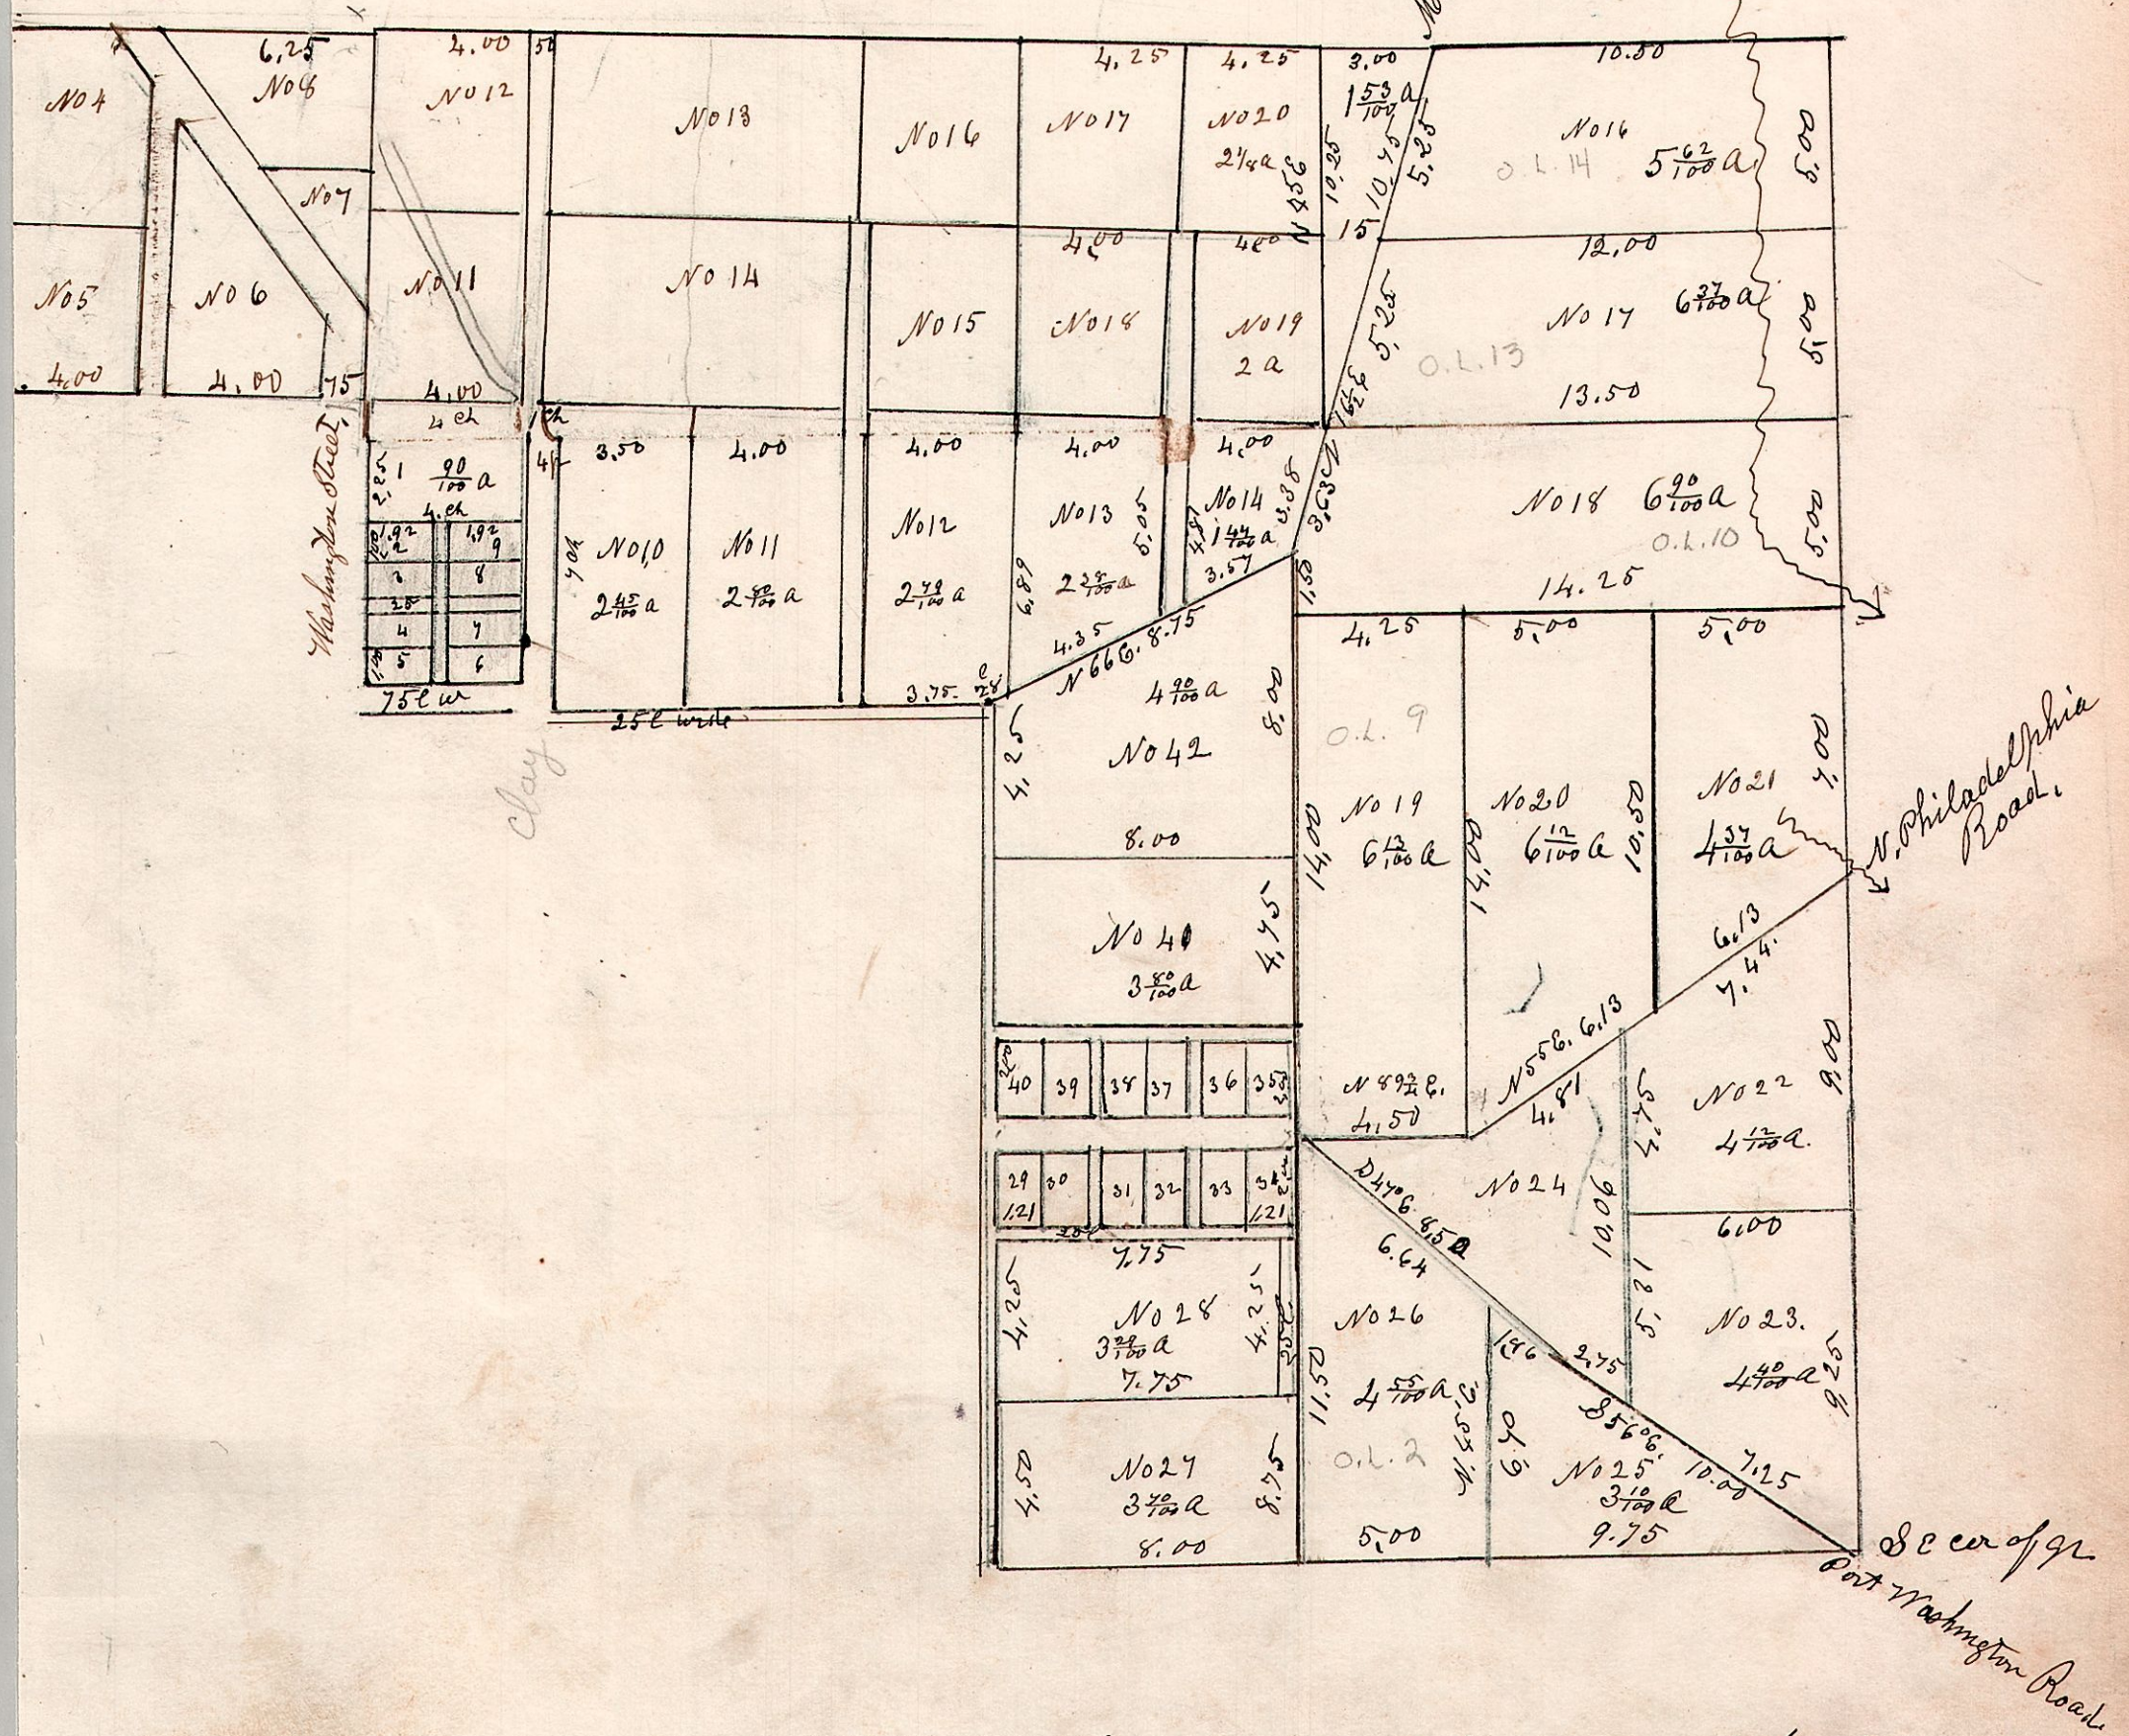

Surveyed the above April 28th 1837. Being the E. pt + pt of the N. part of the Sec 12 of T. 9 of R. 7, belonging to the widow and heirs of Gen A. Johnson of Coshocton Co Ohio.
 Lots 2-3-4-5-6-7-8-9 contain 1/4 of an acre
 Lots 29-30-31-32-33-34-35-36-37-38-39-40 contain 1/4 of an acre each.
 Lots 2-3-4-5-6-7-8-9, to 67 ft 2 inches front & back 127 feet.

6. 9. 4. S.E. Spt of S. E. gr. of Sec 4, T. 9, R. 6
 August 15th 1844.

- A W Oak 30 N 64 8 11.
- Maple 18 West 17.
- B sugar 12 S 43 10 39.
- W. Ash 20 S 79 6 36
- D Ironwood 8 S 68 8 41.
- Beech 7 N 45 6 5.

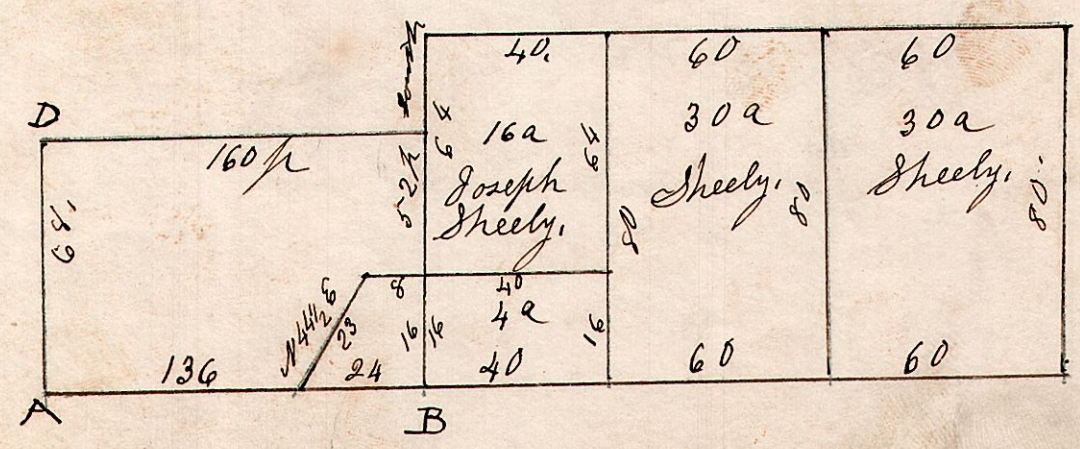

Sec of sw gr 79. 26 1/4