6.9.18. May 29th 1873. Surveyed

the W½ of the W½ of Sec 18. T9. R6.

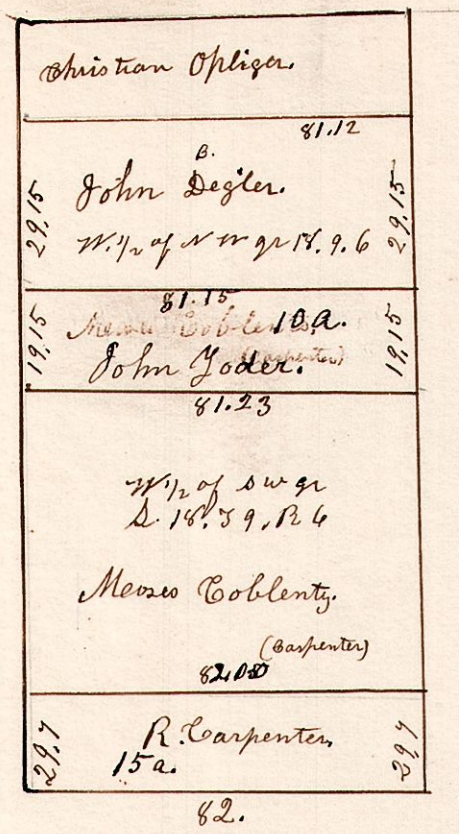

May 29th 1873.

6.9.4.

S.E. qr of Sec 4 T9. R 6.

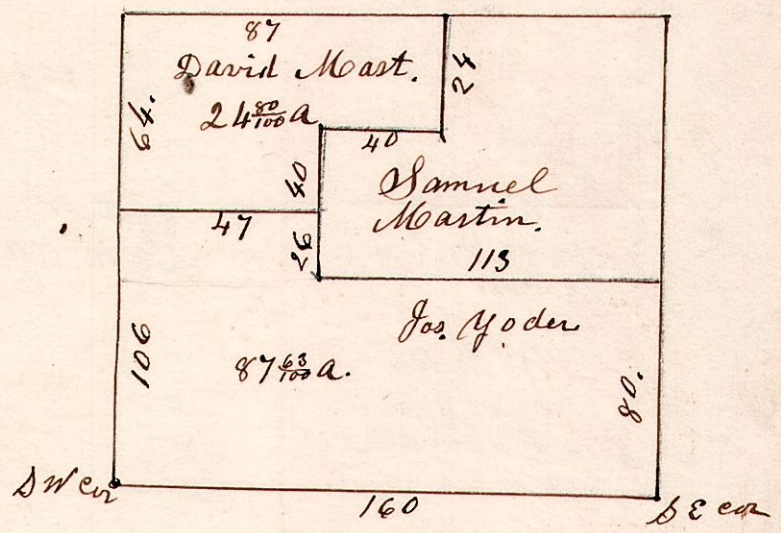

6.9.22. 1st qr. Lot 2 4th qr T9. R6.

Lot 2. 4th qr T9. R6.
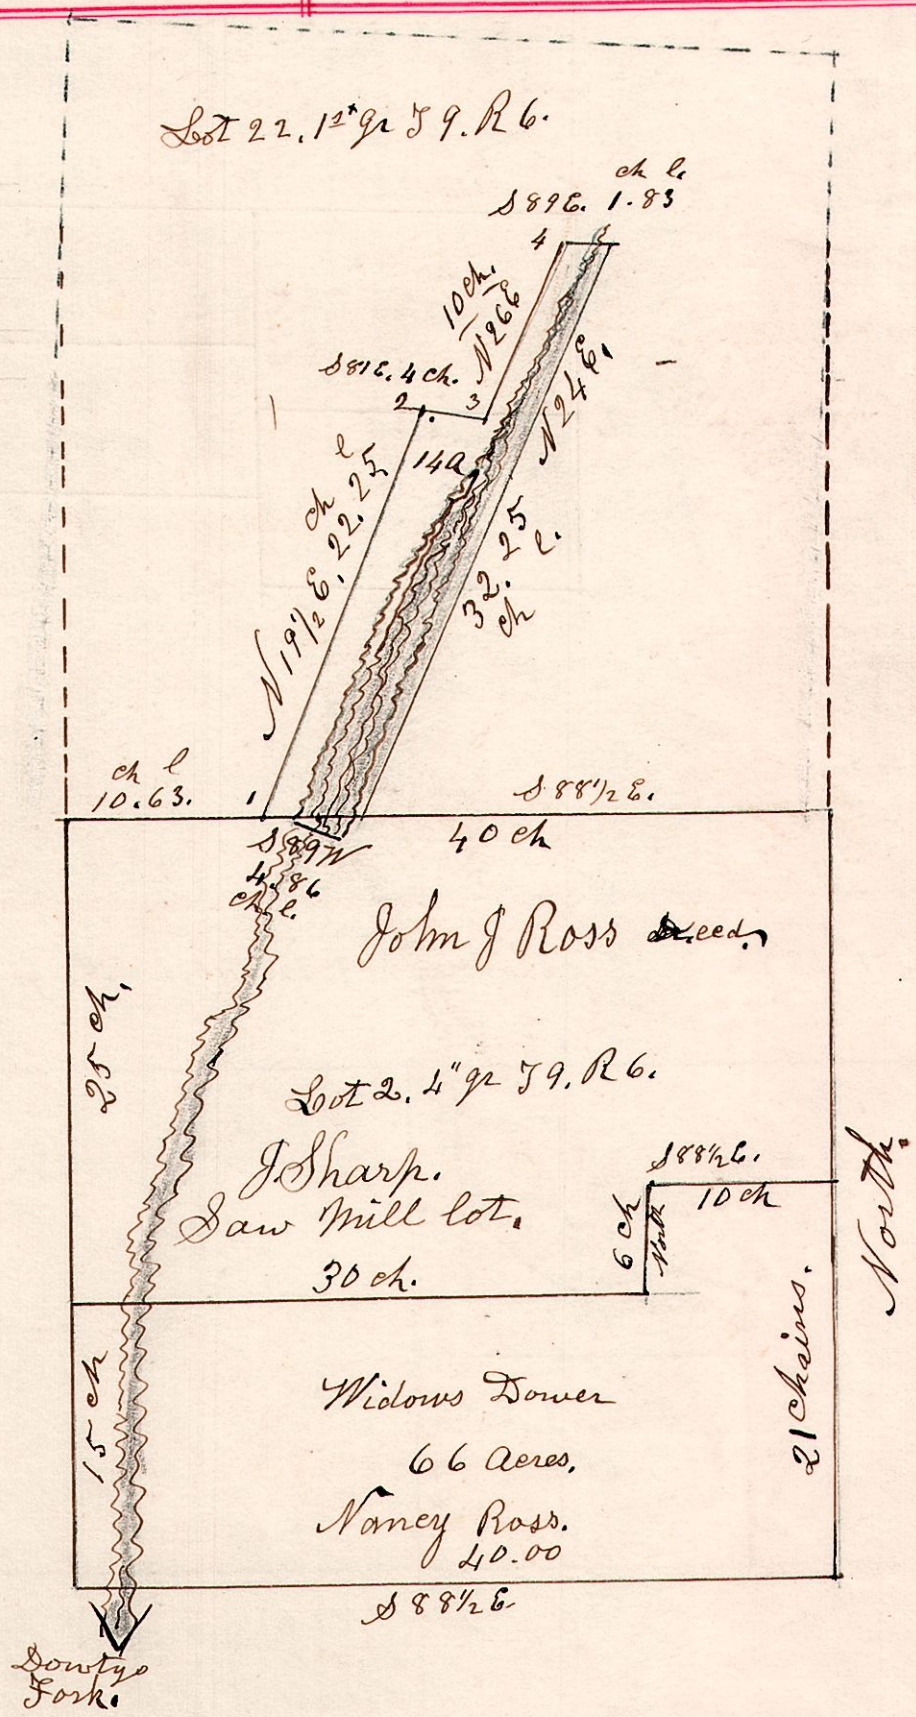
August 28th 1846.