


6. 9. 16 <sup>1/2</sup>


The North half of Fractional Section 16. Township 9. of Range 6.  
Feb 7<sup>th</sup> 1866. 186.2

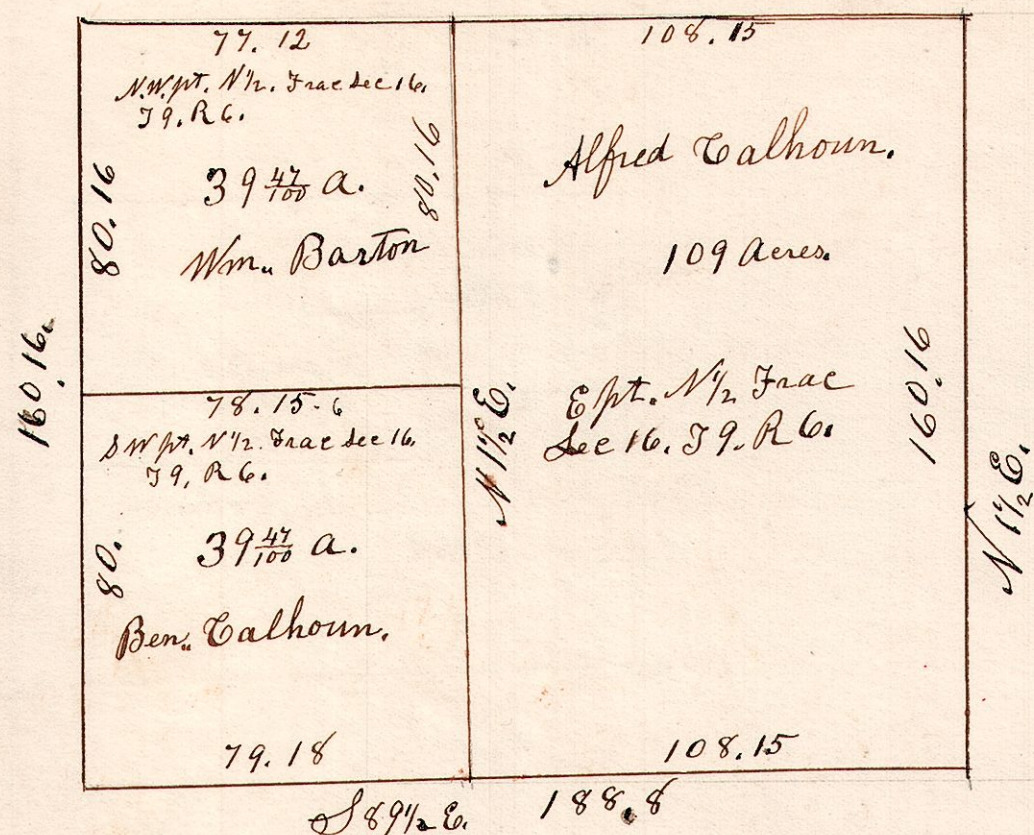

6. 8. 2<sup>nd</sup> Lots 8-9-10. 2<sup>nd</sup> 38. R. 6.

May 21<sup>st</sup> 1873.

C	Maple	14	N 23 1/2 E	14	Good.
D	Walnut	23	S 61 W	23	Not found.
E	W. Oak	12	S 6 W	12	Not found.
F	Hickory	26	N 20 1/2 E	26	Not found.
G	Beech	7	N 21 E	24-28	Not found.
H	W. Oak	30	S 80 1/2 W	48	
I	Hickory	8	N 33 E	40	
J	W. Oak	14	N 22 1/2 E	44	Good.
K	Chestnut	16	N 65 1/2 W	24	
L	W. Oak	48	N 2 E	20	in Road.
M	Do	10	S 29 1/2 E	51	
N	Ash	5	N 19 1/2 E	10	
O	Do	5	S 57 W	26	Not found.
P	Ironwood	5	S 22 W	3	
Q	Hickory	7	N 15 1/2 W	23	Not found.
R	W. Oak	15	N 20 W	28	Good.
S	Maple	7	S 13 E	19	

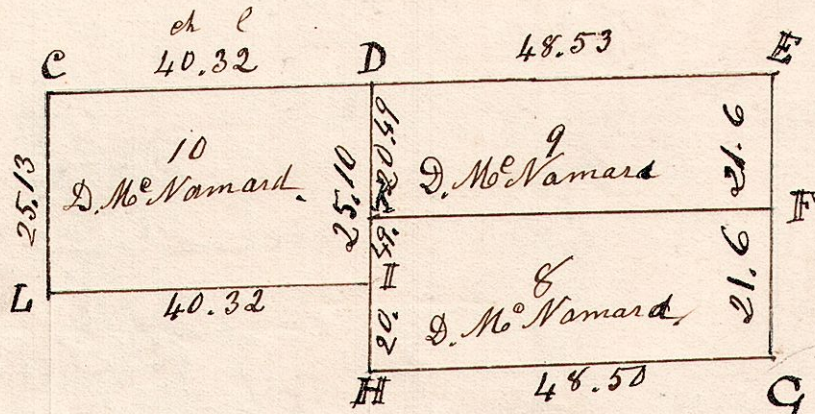

May 21<sup>st</sup> 1873. Surveyed the outside lines of the above.

6. 8. 1.

June 11<sup>th</sup> 1873. Section No. 1. in Township 8. of Range 6.

Wheaton 13 3/4 a. in 1 piece.

