



6.8.1. N.E. q. of Section 1. in Township 8. of Range 6.

December 28th 1849.
5¹/₂ a piece surveyed
Dr. surveyed Nov 11th 1839.

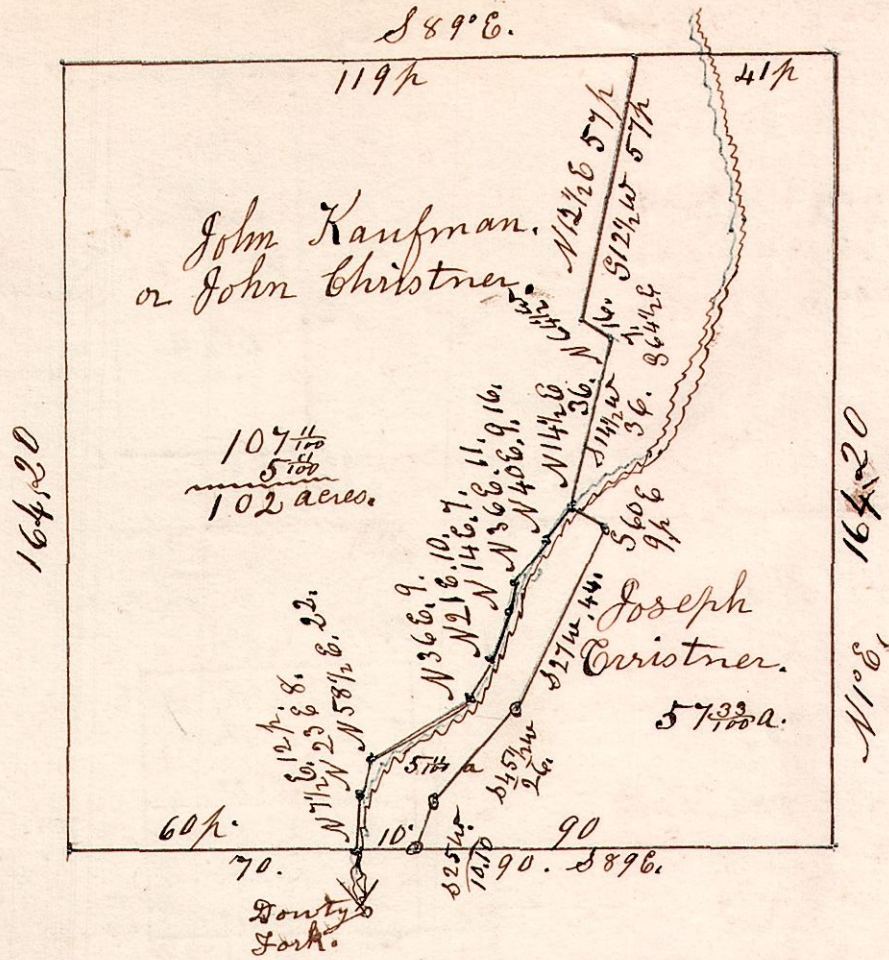


6.8.3. October 2nd 1872.
N.E. q. of Sec 3. in T. 8. of R. 6.

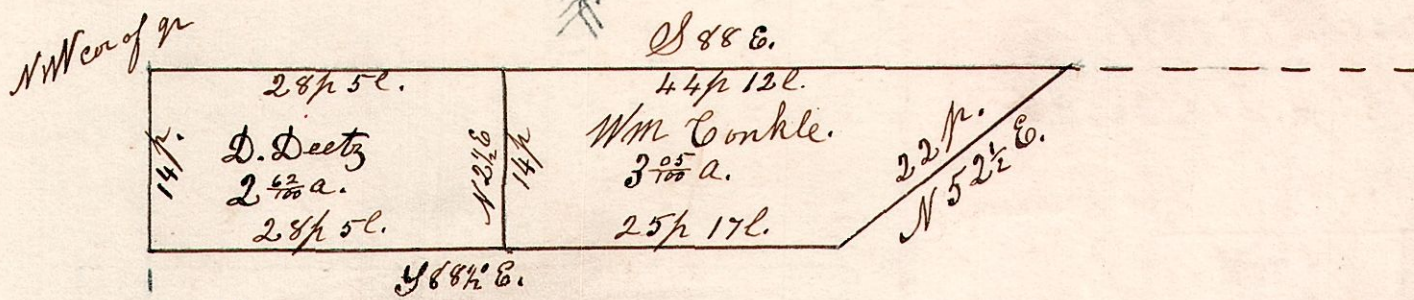

Surveyed the above part, of the north east of the north east quarter of Section Number 3, in Township number 8 of Range number 6.
October 6th 1872. Saml H. H. Robinson Surveyor.

6.8.8. N.E. q. of Sec 8. T. 8. R. 6.
April 13th 1850.

Surveyed A.S. Wade
10 acres.

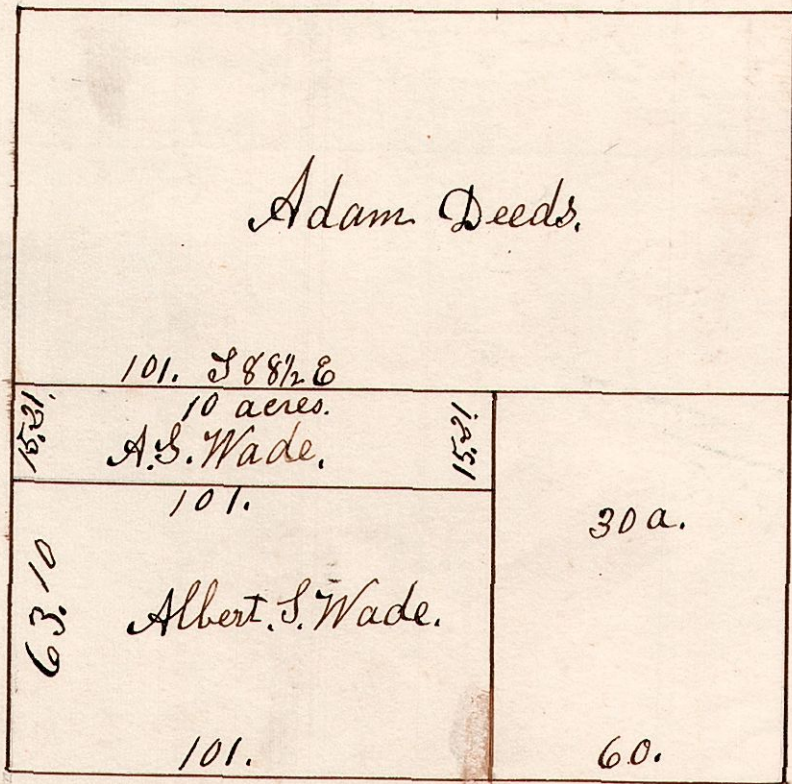

6.8.8. April 13th 1836.
E. 1/2 of S 8. T. 8. R. 6.

