


December 5th 1844.

Surveyed the South part of lot 5, in the 12th quarter of Township 9, Range 6, W.R.S.

98-21
24-15
30
153-11

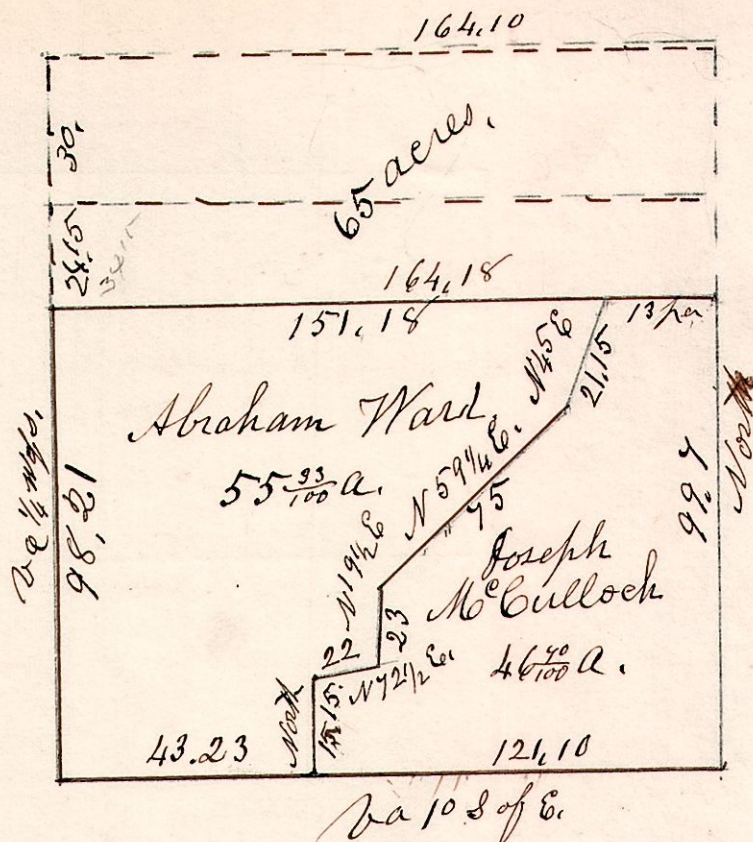


65
120

249

1121
1214 30

6.9.4. June 9th 1826. Section 4, Township 9, Range 6.

A	Poplar	30	S 49 E	13
"	Oak	20	S 48 W	46
B	Sugar	12	S 43 W	39
"	Do	10	S 32 E	40
C	Chestnut	36	South	23
"	W. Oak	20	N 57 E	24
D	Poplar	24	N 10 E	40
"	Gum	8	N 30 W	43
E	Poplar	30	S 75 E	10
"	Gum	6	N 54 E	15

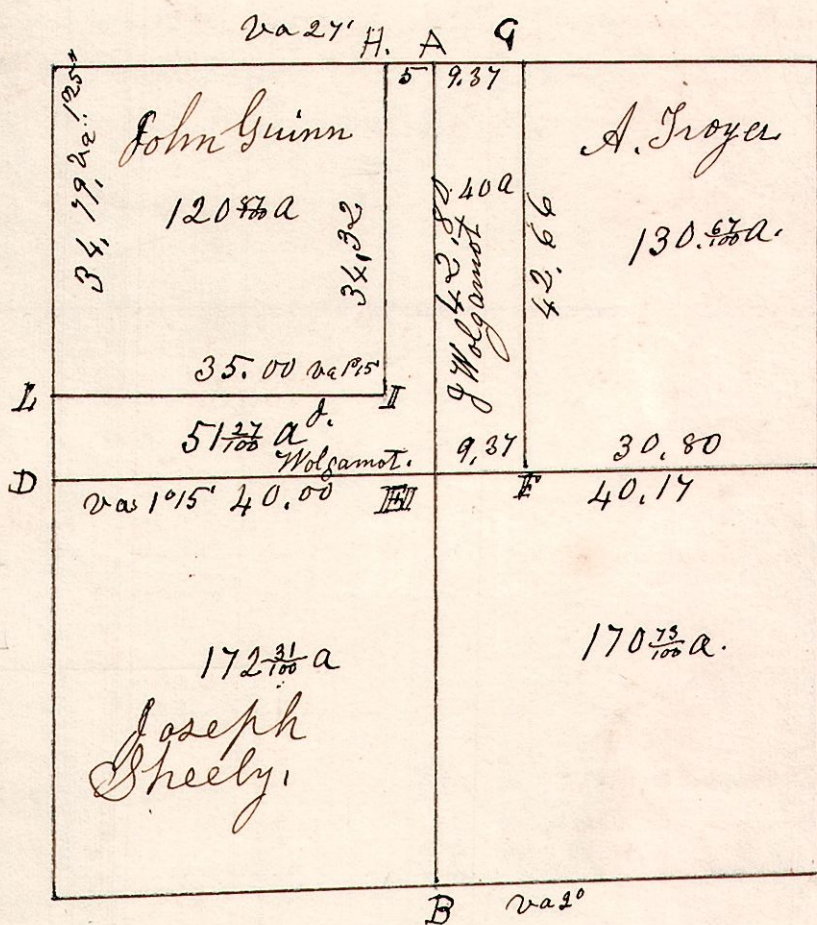

F	Beech	10	N 63 W	17
"	Maple	10	N 9 E	20
G	W. Oak	30	N 69 E	6
"	Maple	12	N 32 W	18
H	Elm	14	N 11 W	4
I	W. Oak	10	N 67 E	17
J	Beech	14	S 15 W	18
"	Maple	18	S 24 E	8
K	W. Oak	12	N 19 E	21
"	Do	12	S 24 E	13

Surveyed the above June 9th 1826.
Being Section No. 4, in Township No. 9, of Range 6, of which the above is a correct plat of the same.
Samuel Robinson
Co. Surveyor.