


5. 8. 16.


April 2^d 1856.
The north east quarter of section 16 in Township 8 of Range 5.
S 89 1/2° E.

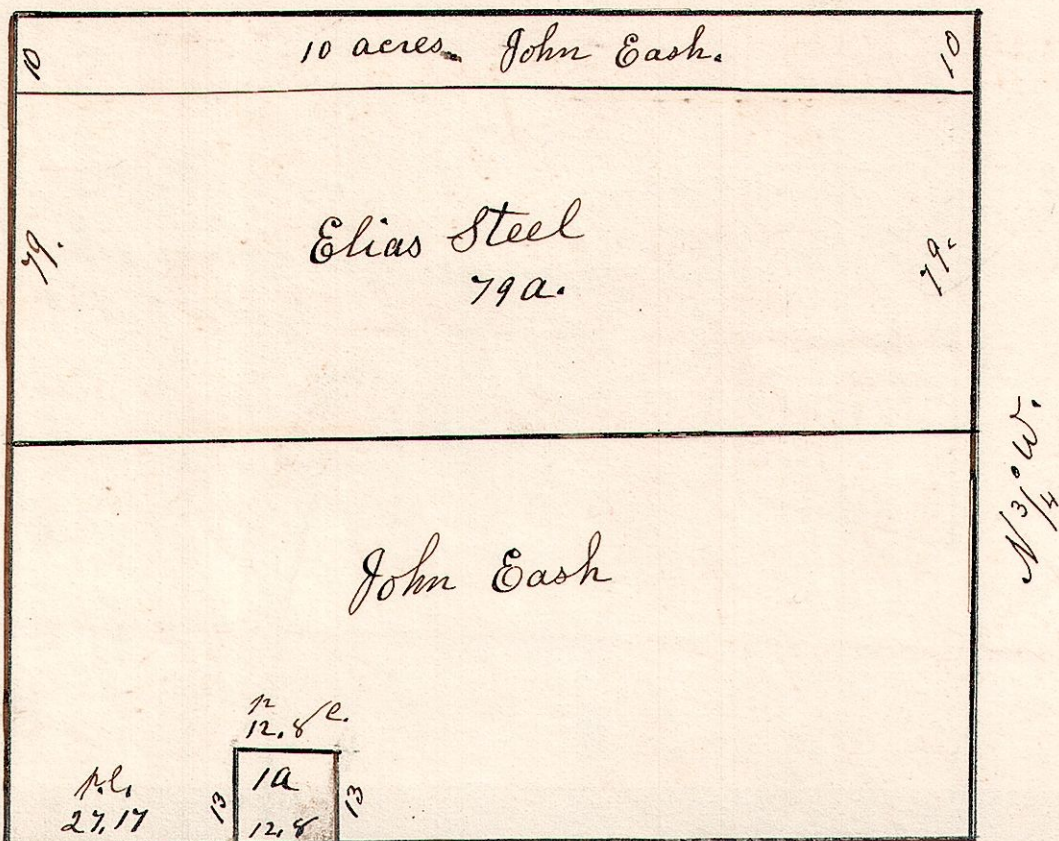

One acre piece (orchard) Elias Steel.


5. 8. 7.

Divided the south west quarter of section 7.
in Township 8 of Range 5 as follows.

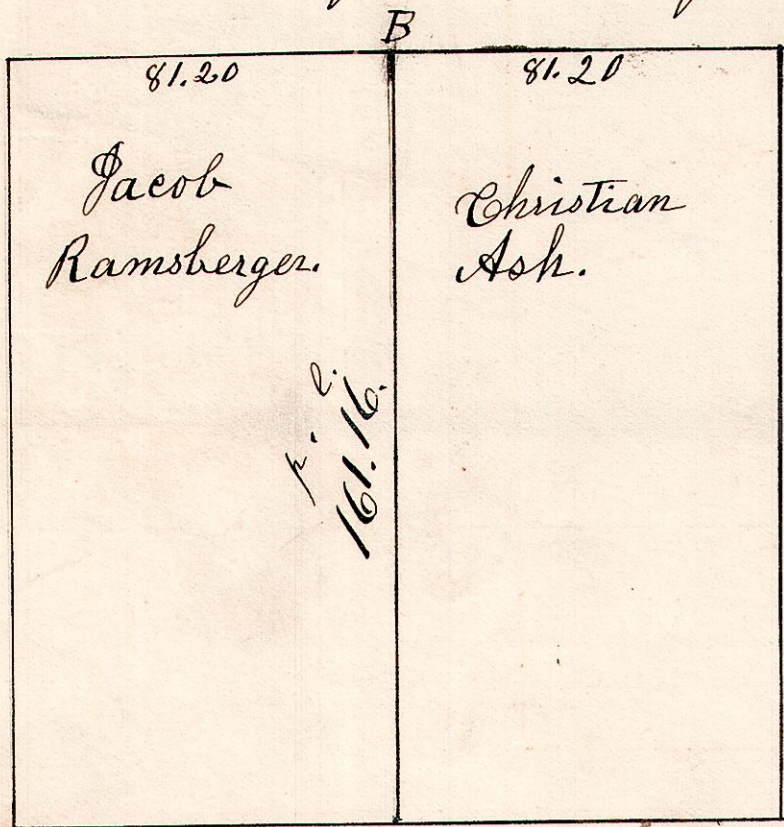

Stone Corner.

5. 10. 17 & 19, 3 3/4. August 12^d 1856.

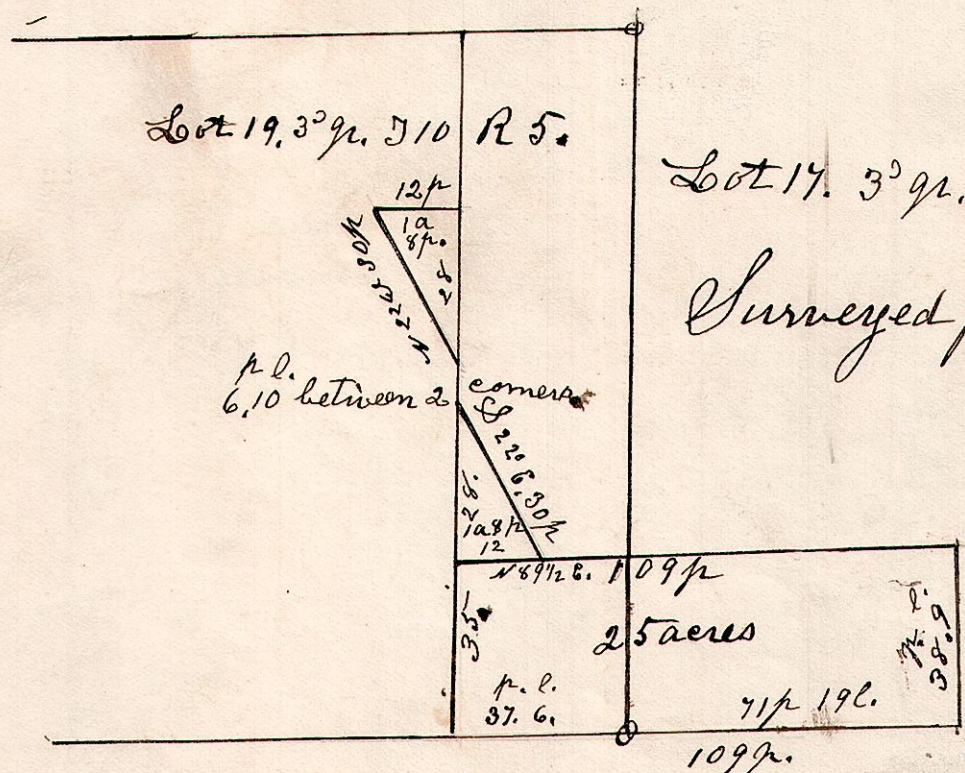

Surveyed for Sam Troyer