


5.9.4. April 8th 1853.

767

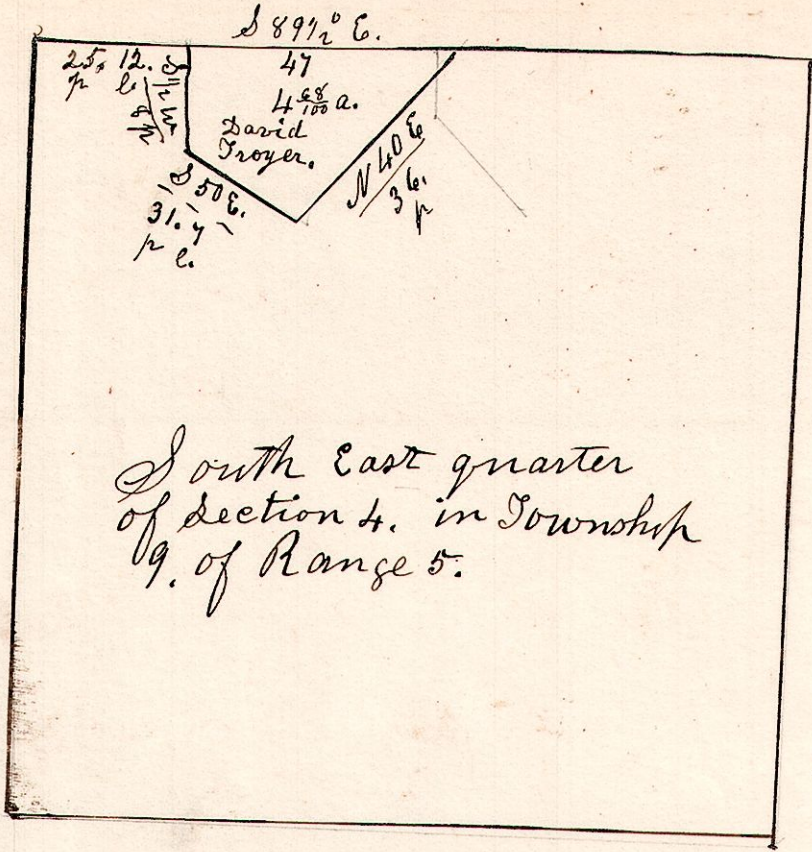


Surveyed for David Troyer April 8th 1853.

South East quarter of section 4. in Township 9. of Range 5.

5.9.7. February 15th 1834.

768

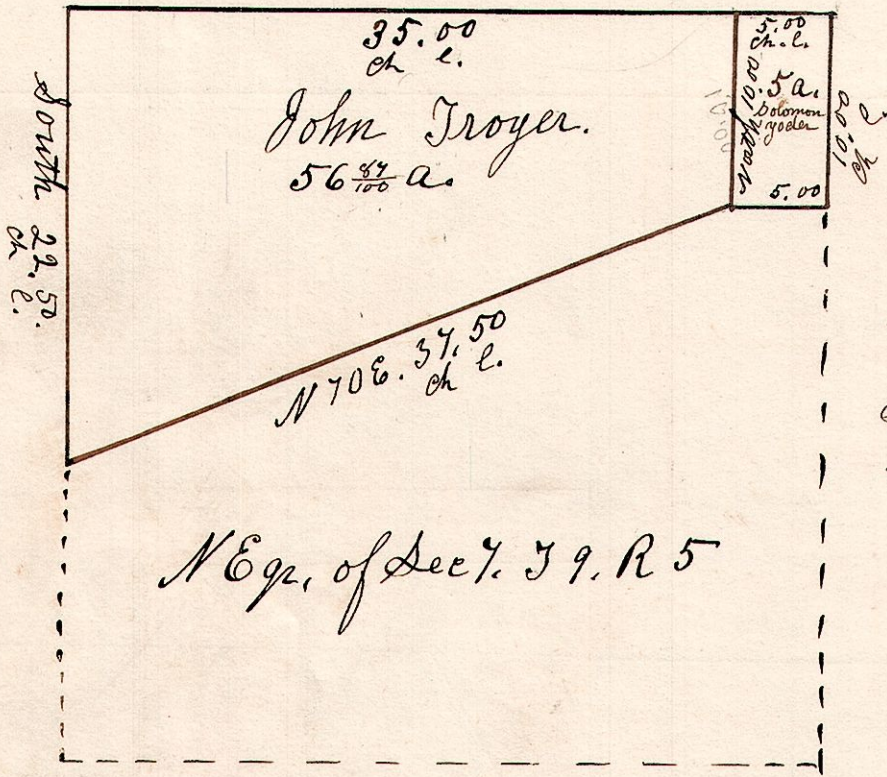

Surveyed February 15th 1834. as above. See Gabriel Hochstetters Survey.

5.10.3. 4th February 26th 1835

769

Surveyed the North East part of Lot No 3. in Township 10 of Range 5. 4th q.

