


6. 8. 10. September 27<sup>th</sup> 1841.

977

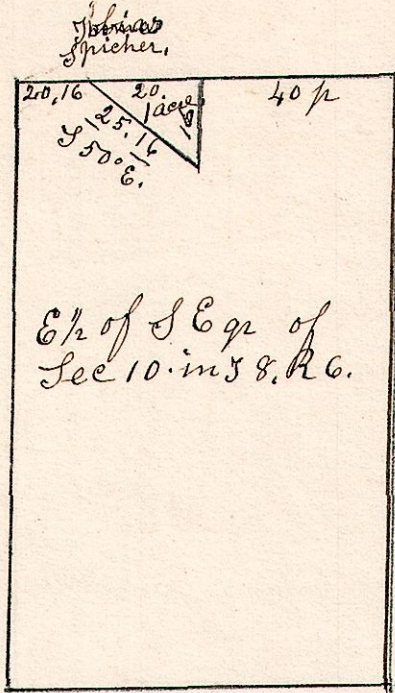

Surveyed the 1 acre piece  
September 27<sup>th</sup> 1841.  
for Tobias Speicher.

6. 9. 15.

May 12<sup>th</sup> 1829. Surveyed Section No 15  
in Township 9 of Range 6. in the following  
manner and for the following persons.

A	W. Oak	36	S 71 W	56.
	Do	40	N 65 E	43.
B	W. Oak	20	N 40 W	8.
	Do	10	N 24 E	21.
C	W. Oak	16	N 12 W	22
	Do	15	S 1 E	23
D	W. Oak	25	S 25 W	24
	Lronwood	8	N 45 E	4
E	W. Oak	20	N 21 W	29
	Do	24	S 9 W	13
F	Apple	12	S 35 E	13
	Do	11	N 88 W	40
G	Post			1
H	W. Oak	20	N 46 E	10.
	Do	14	S 6 W	36
I	W. Oak	16	N 42 W	32
	Hickory	14	S 24 W	12
L	Stone Corner			
M	Beech	18	S 71 W	11
	Hickory	8	S 74 E	27
N	Lronwood	8	N 38 W	5
	W. Oak	25	West	26
O	W. Oak	22	N 71 W	40
	Do	20	N 60 S	43
P	W. Oak	24	S 11 E	18
	Dogwood	8	N 85 W	12
R	W. Oak	26	N 74 E	14
	Do	26	N 25 W	36
S	W. Oak	40	S 48 W	5
	Beech	4	S 39 E	14

