250

6. 8. 10. April 19th 1851

Part of the north East quarter of Section 10, in Township 8. of Range 6.

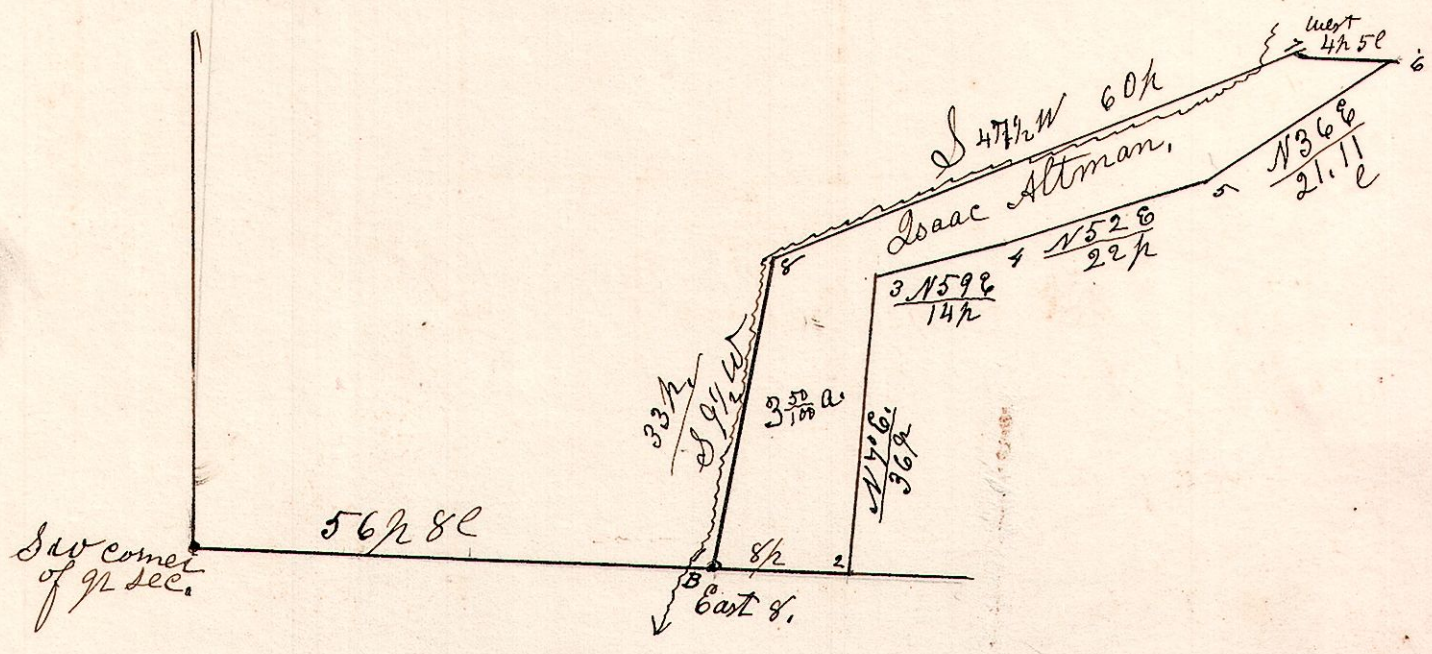

6. 9. 24. March 27th 1850.

N.E. qr of Sec 24. T 9. R 6.

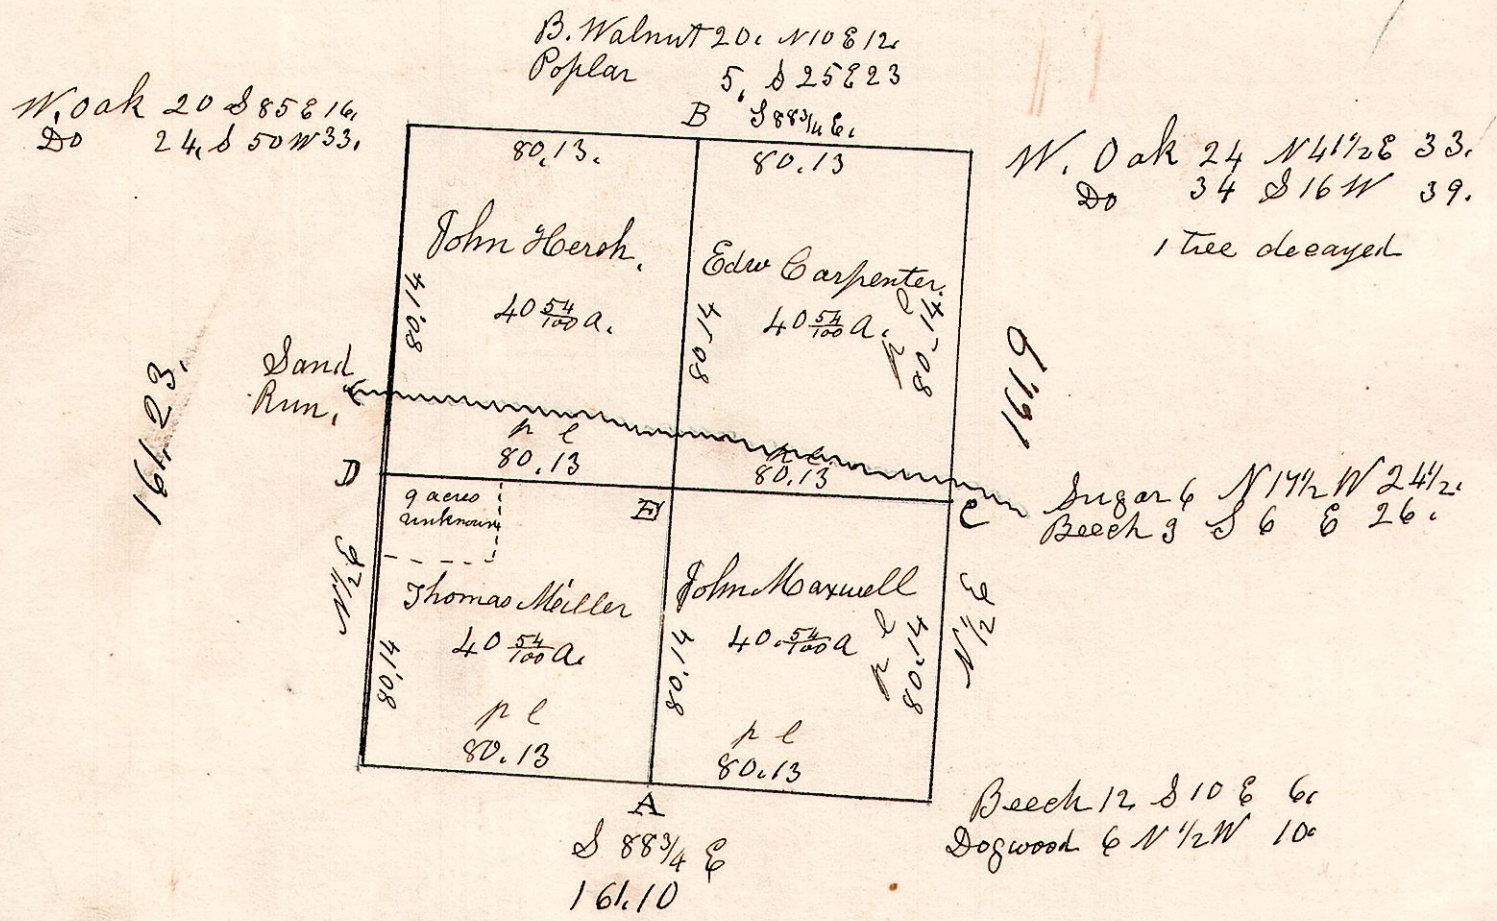

E & W Center line 161.2

March 27th 1850.

A. Hickory 20 S 48 E 19.
" Chestnut 4 S 67 W 33.

E Gum 18 N 65 W 19.
" Do 12 N 46 E 26½.

7