


6. 9. 5. April 17<sup>th</sup> 1861.

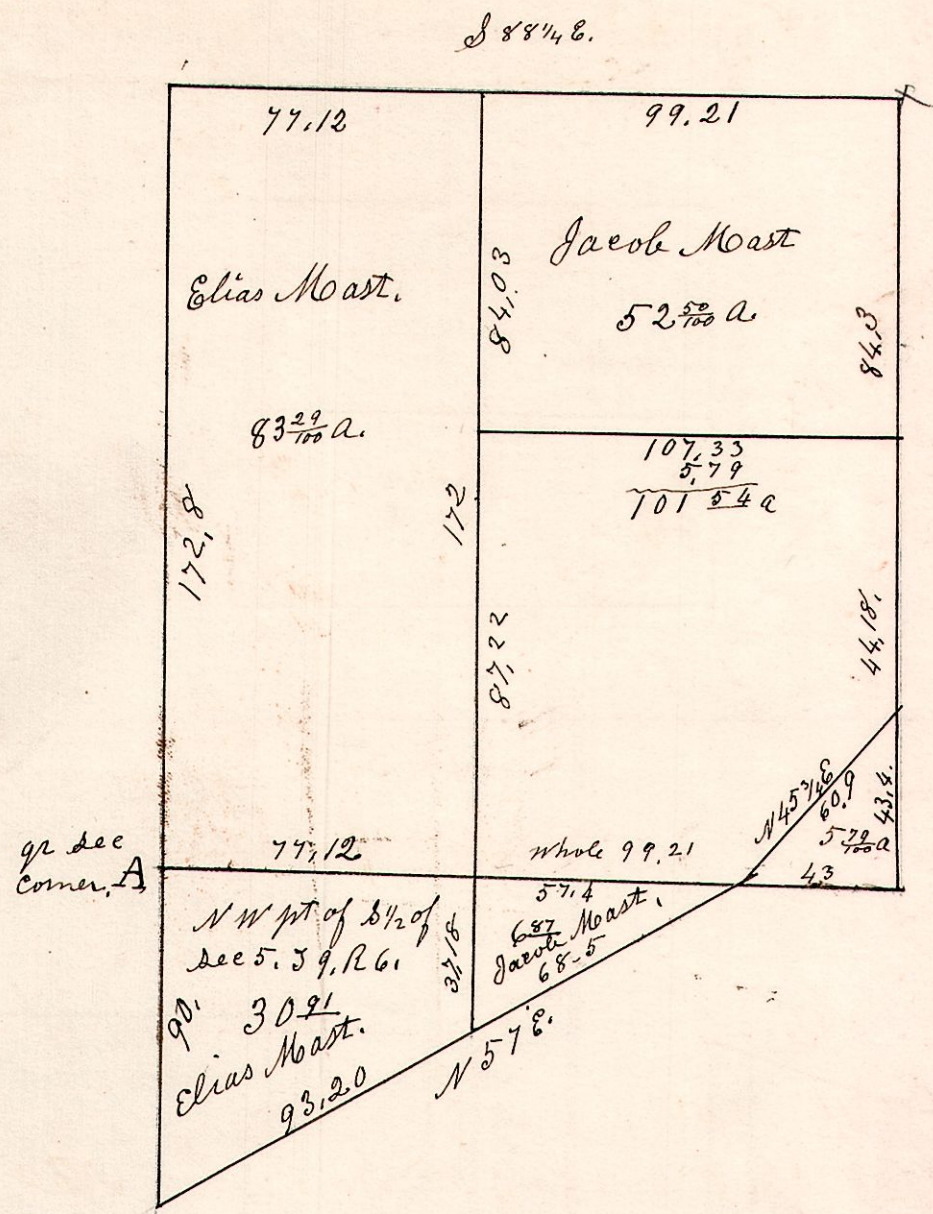

6. 9. 24. February 6<sup>th</sup> 1869.  
 SW q. of N.W. q. Sec 24. T9. R6.  
 N.W. cor. S 88 1/2 E

