



6.9.9. $\frac{120}{2}$.

S.W. qtr of lot No 9. in 1st gr. 59. R 6.

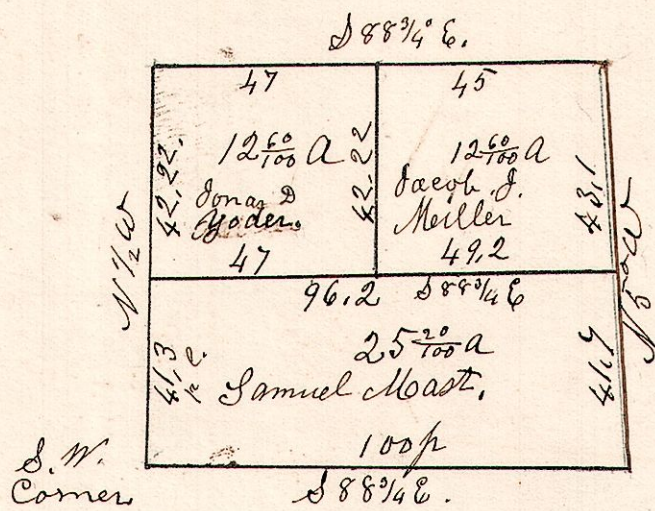


6.9.14.

South East qtr of Sec 14. 59. R 6.

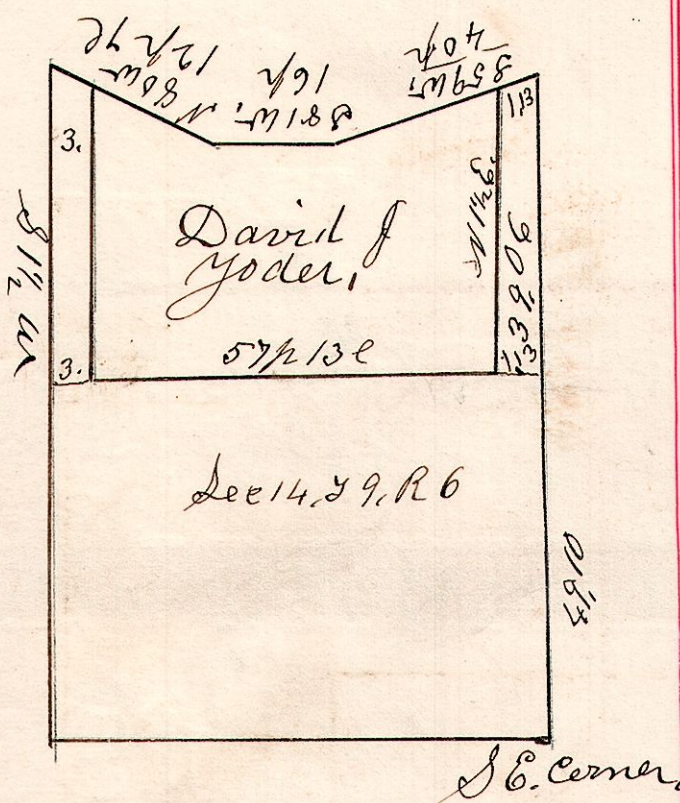

6.9.5.

April 2 1842

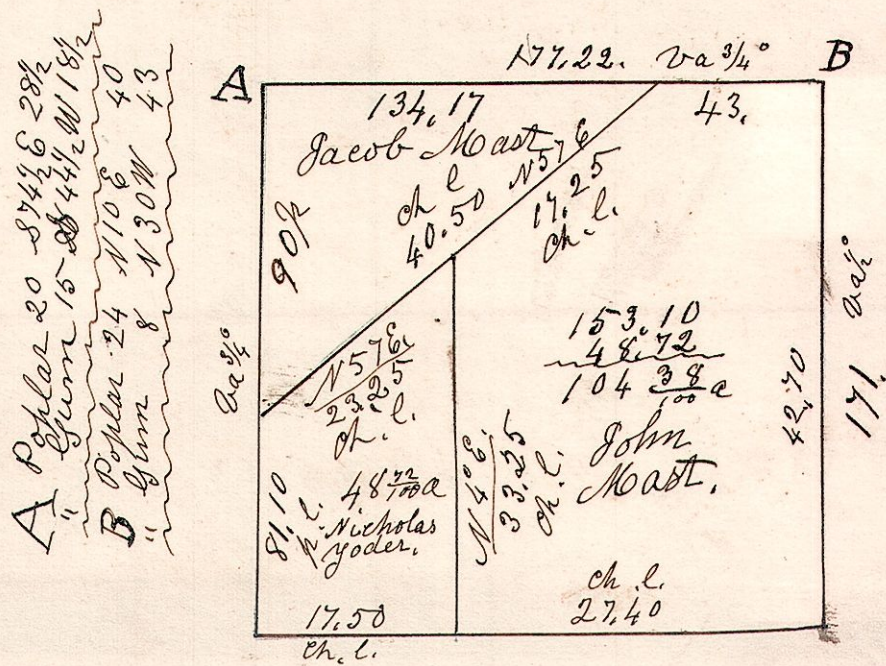

Dec 7 1844. Surveyed the 48.72 piece.

6.9.7. April 23 1844

NW qtr. Section 7 in Township 9 of Range 6.

