

15. 19. 1


November - 1826

Section 1. in Sp 19. of Range 15.

B. oak 7 S 82 E 38.
5 S 70 W 28.

B. oak 8 N 20 1/2 W 139
Gum 14 S 22 W 216

405

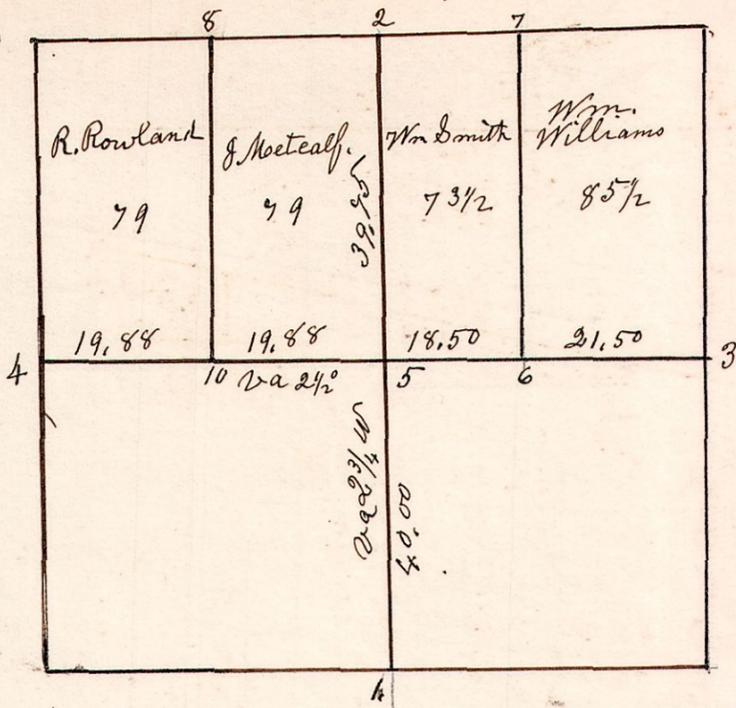

- 1. W. Oak 20, S 46 W 22 - Do 15 N 28 W 40.
- 2. W. Oak 14 N 59 W 51 - Do 24 N 77 E 18.
- 3. W. Oak 18 N 46 E 19 - Do 10 S 32 W 11.
- 5. W. Oak 40 N 51 W 7 1/2 - Gum 18 N 17 E 4 1/2.
- 6. W. Oak 13 N 19 E 9 - Hickory 13 S 70 W 34 1/2.
- 7. W. Oak 40 N 28 W 5 - Gum 12 N 87 E 12.
- 8. W. Oak 24 N 89 W 25 - Do 15 S 40 W 32 1/2.
- 10. W. Oak 15 N 6 W 10 - Do 14 N 50 E 31.

15. 19. 17. November 28th 1854.

406

N E q. of Sec 17. S 19. R 15.

R. W. Oak 5 S 25 E 20.
" Maple 8 N 68 E 48.

R. Wa 3 1/4 N of E.

W. Oak 15 N 28 W 25.
Do 20 S 25 E 23.

