


6. 10. 1849. 4" gr.

September 12 1855.

Lot 19. 4" gr. 510. R 6


Lot 18. 4" gr. 510. R 6.

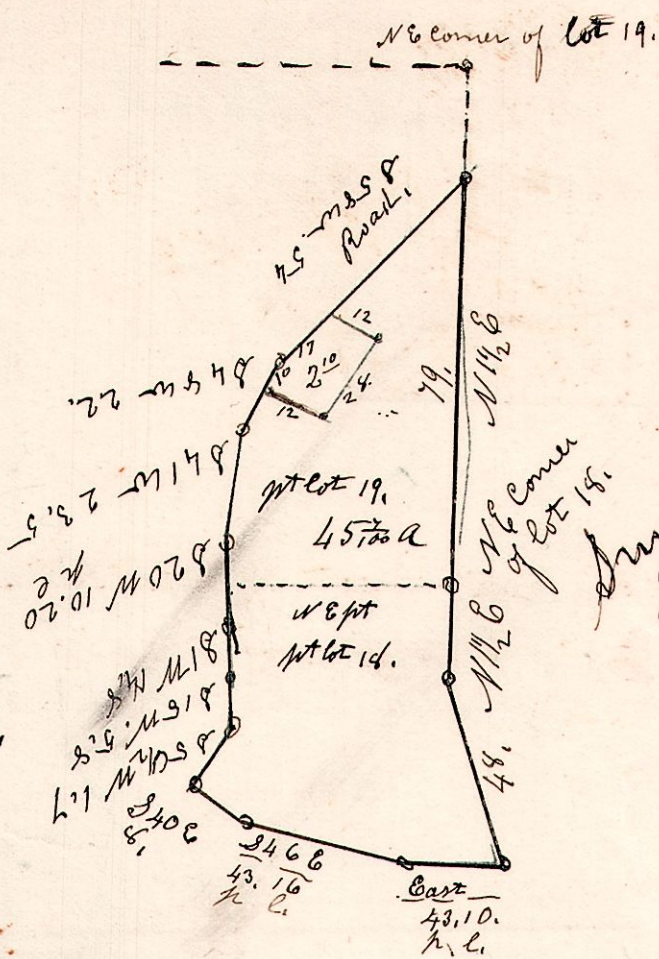

6. 10. 18. 4" gr

April 15 1851.

Surveyed
 1/4 acre which was sold
 to James Divers at
 Auditor's Sale January
 10th 1848 by Robert Justice
 A. H. C. Perry part of lot 18.
 in Sp 10. R 6. 4" gr.
 Commencing S 31 1/2 W 3 perches
 from the S W corner of
 out lot No 1. at Martinsburg
 Holmes County Ohio.
 April 16th 1851.

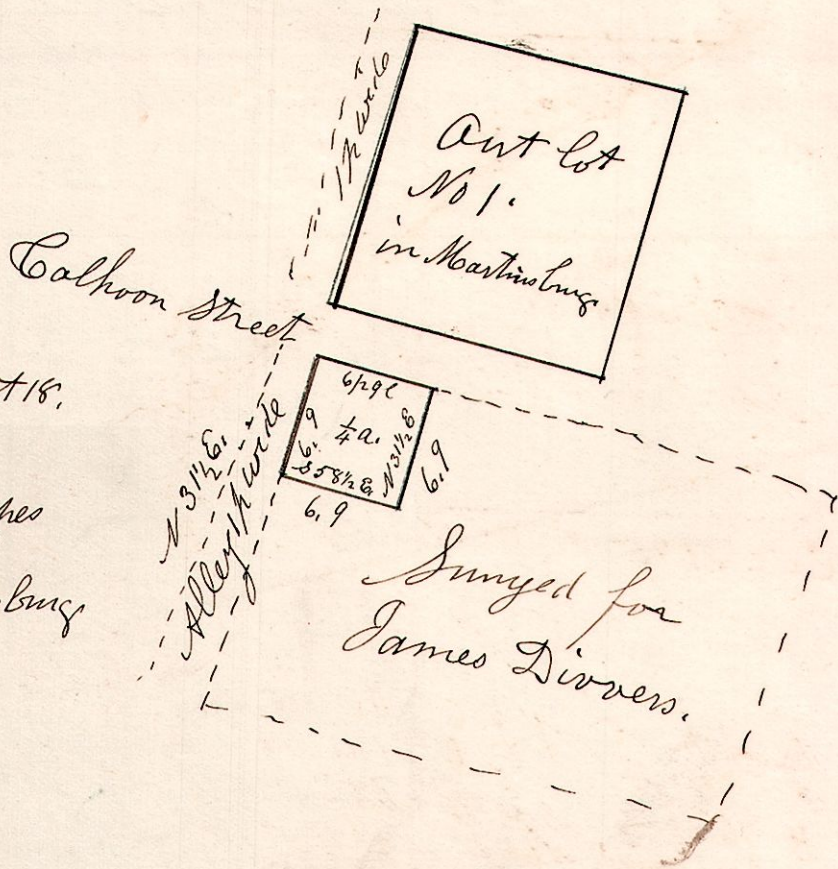

3