7-9-13. 3d qr.

June 1st 1863.

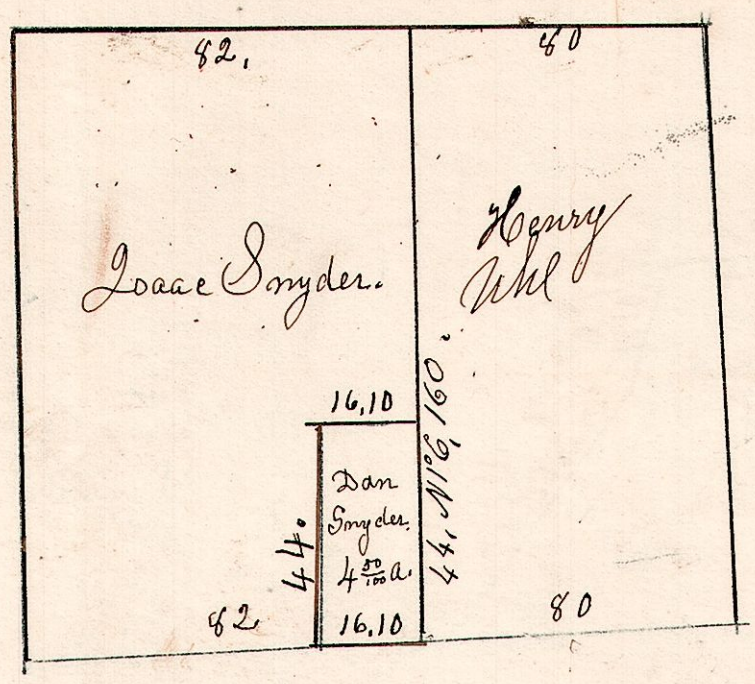

7-9-26 1st qr

Lot 26 1st qr. Tp 9. R 7.
Connecticut Western Reserve
School Land.

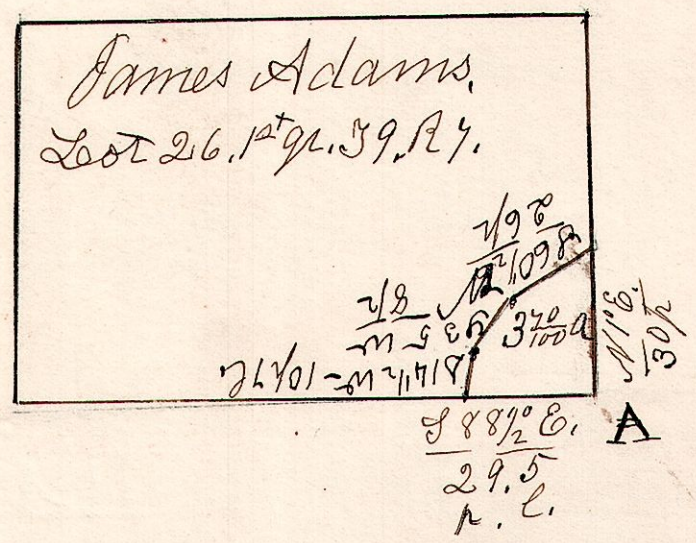

A. 26. N 27 W 2.
M. 31. S 56½ W 26. S E cor of lot 26.

Surveyed March 29th 1850.

S E part of lot 26. 1st qr. T9. R 7.
3 70/100 acres. for James H. Henderson
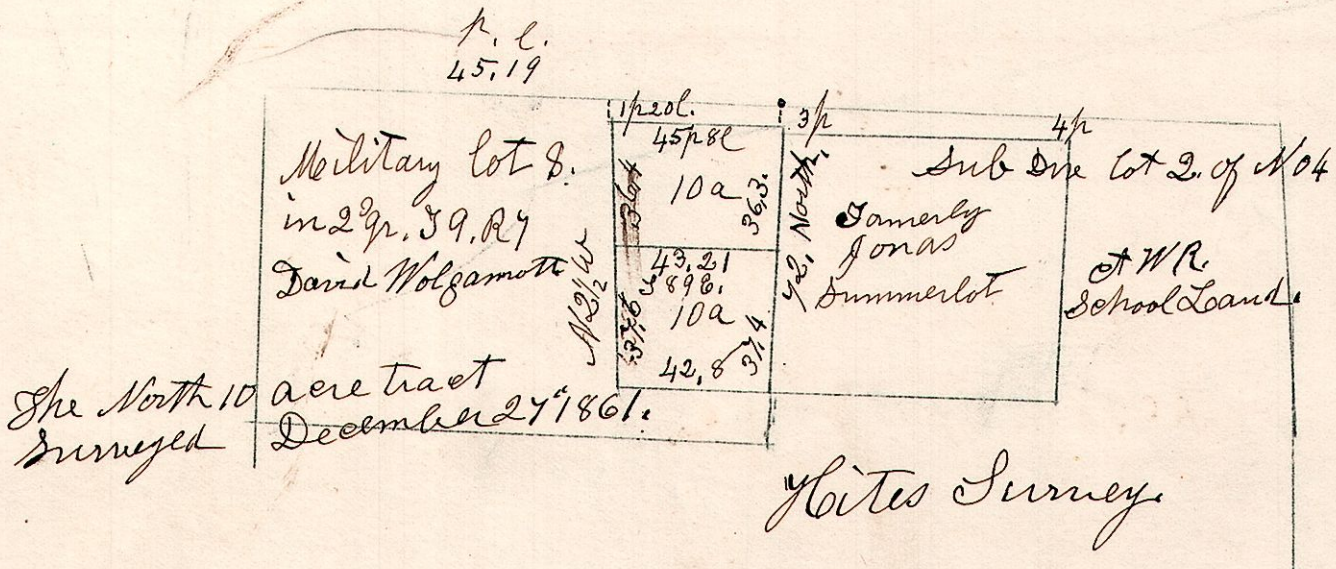
7-9. 8. 2½ qr.