5. 8. 12. N E qr.

March 23 1857. Surveyed the following lots for the persons with their names written in the plats. Situated on the N pt E of the E½ of the N E qr. of Sec 12. in Tp 8. of R 5.

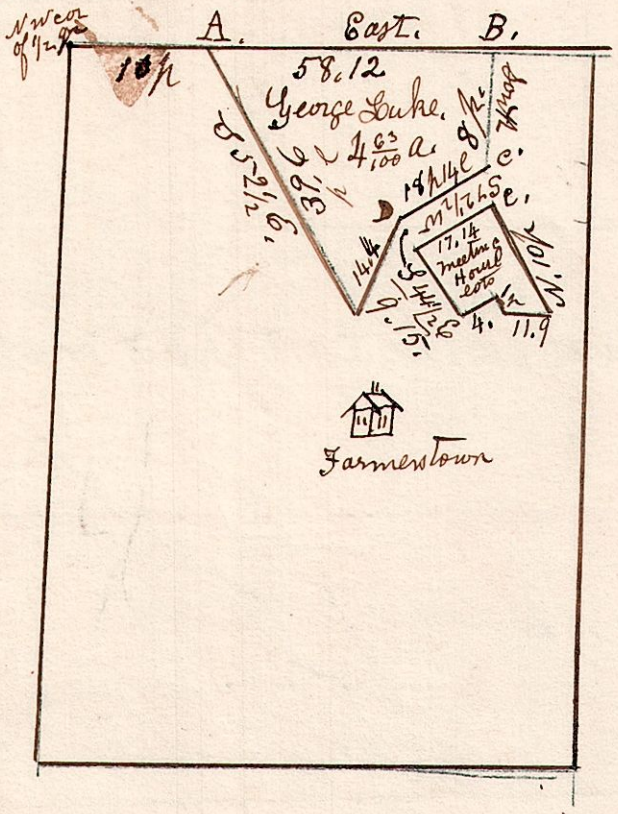

C-C. Corners together.

George Lukes Contains 4 63/100 Acres.
The Meeting house lot Contains 72/100 of an Acre.

5-8-10. N W qr.

December 22d 1855.

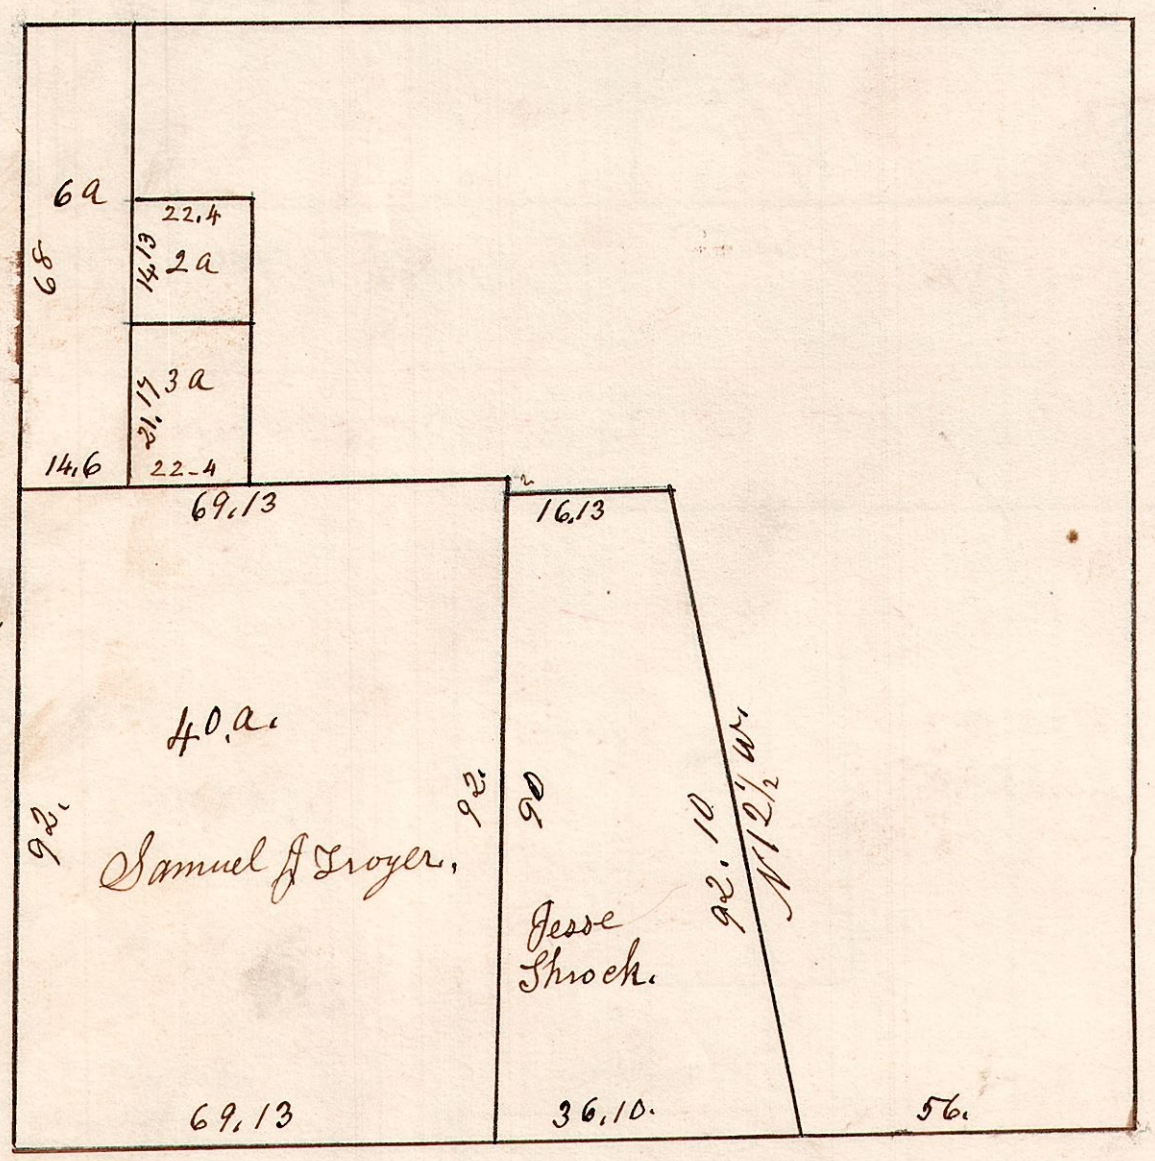

December 22d 1855. Surveyed 9 Troyer pieces & Jesse Shrocks pieces.
The other pieces were not surveyed.