



6-10-5-4th q^r.
12-14-10,

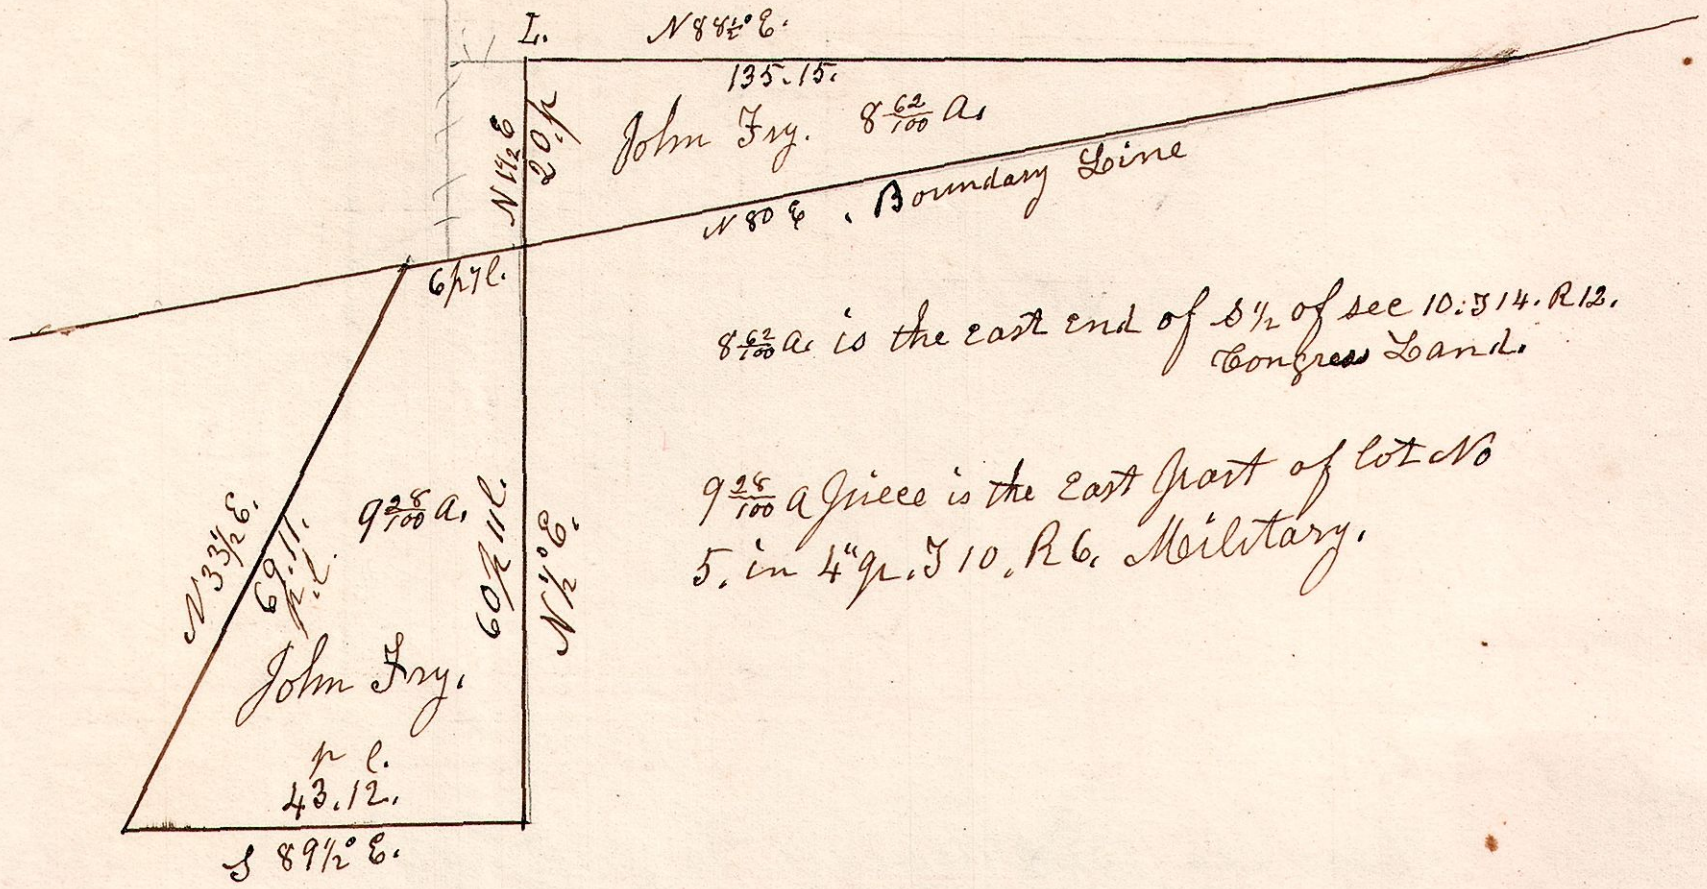

4-10-20-3rd q^r.

Feb 14th 1834.
Surveyed the above
Private Survey.

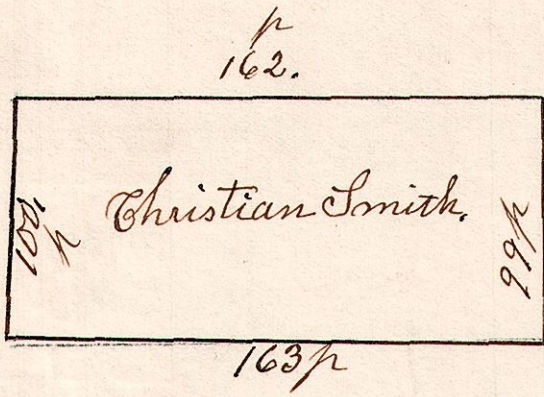

6-9-20-4th q^r.

September 12th 1836.

Surveyed the above Sept 12th 1836,
Being the N part of lot No 20,
in 4th q^r S. in 2nd q^r of R 6. of the
Ct. W. R. School Lands. (Berlin)
Surveyed for Benjamin Remains.

