R. 7. Tp. 9. Lot. 39.
2nd Cr.

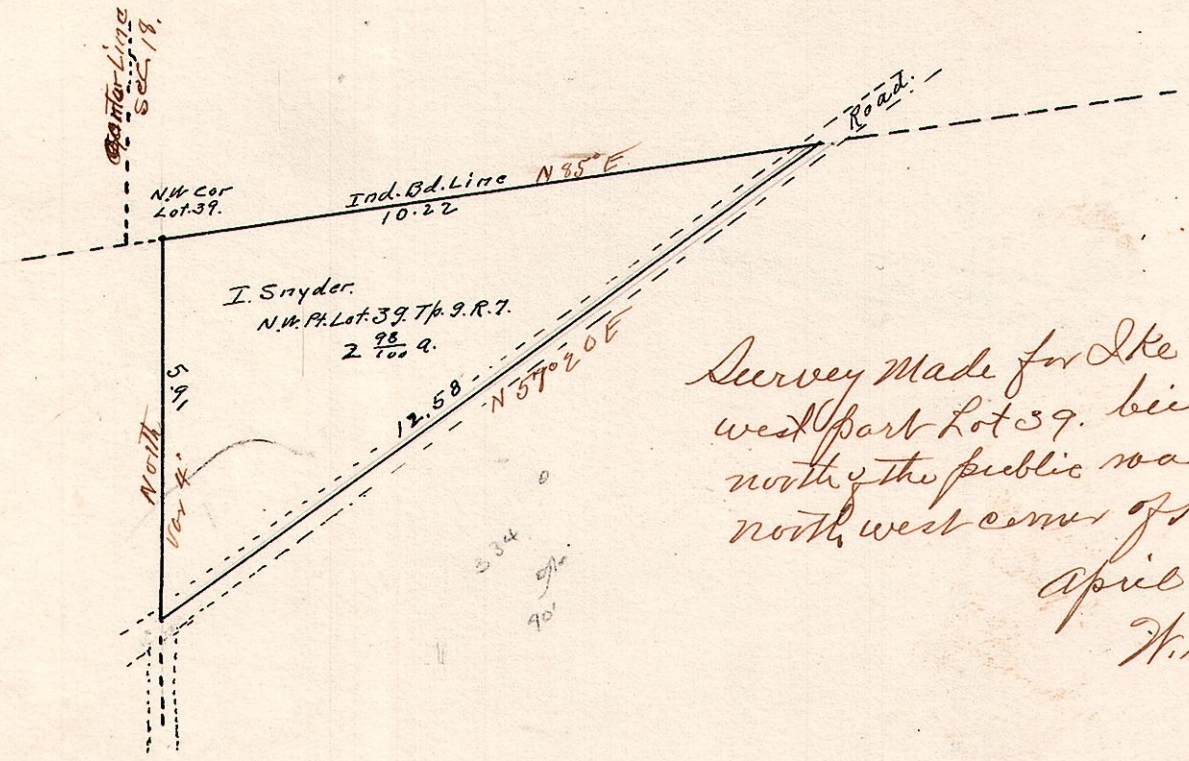

Survey Made for Ike Snyder of North west Part Lot 39. being that part lying north of the public road and in the north west corner of Hardy Tp.
April 10. 1916.
W. L. Reidenbach
Dep. Co Surveyor.

R 8. T 8 Sec 7.

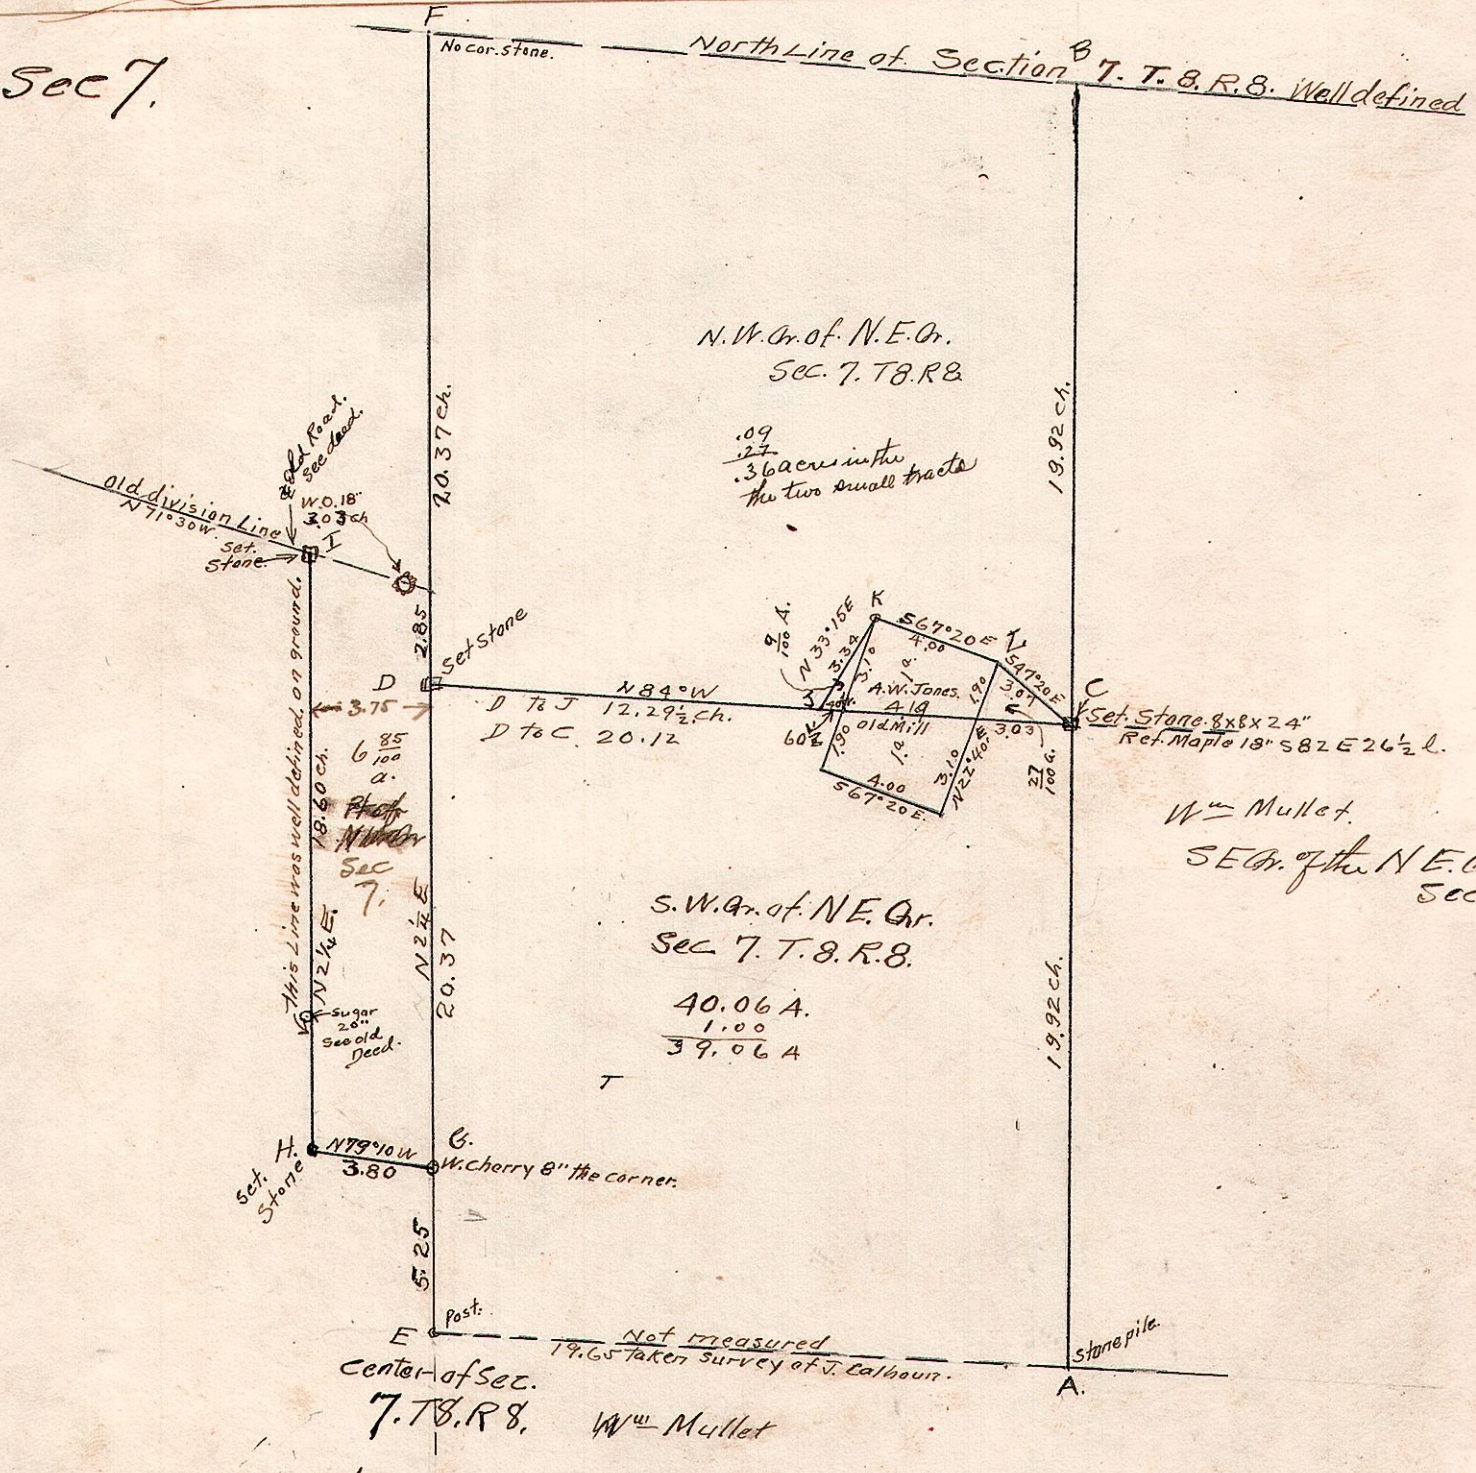

Legal survey made for. Frank Jones. A.W. Jones. Chas Jones et al to establish corners C & D and line C D and also to get discription of the 9/100 a tract and the 27/100 acre tract adjoining the old mill site now owned by A. W. Jones. I measured line A B & set corner C midway. measured line E F and set corner D midway. The 6.85 a. tract was well defined on ground and corresponds to the calls of the old deed.
Surveyed. April 25th 1918.

Wm Hastings } Chairman
W.C. Jones } Sworn.

Notice was served on Wm Mullet and Miles Pyers. April 3. 1918. by Frank Jones.

Present: Wm Mullet. A.W. Jones. Frank Jones. Chas Jones. Russel Jones and others.

H. H. Palmer Co Surveyor.
by W. L. Reidenbach Deputy.