S-6 T-8 R-7

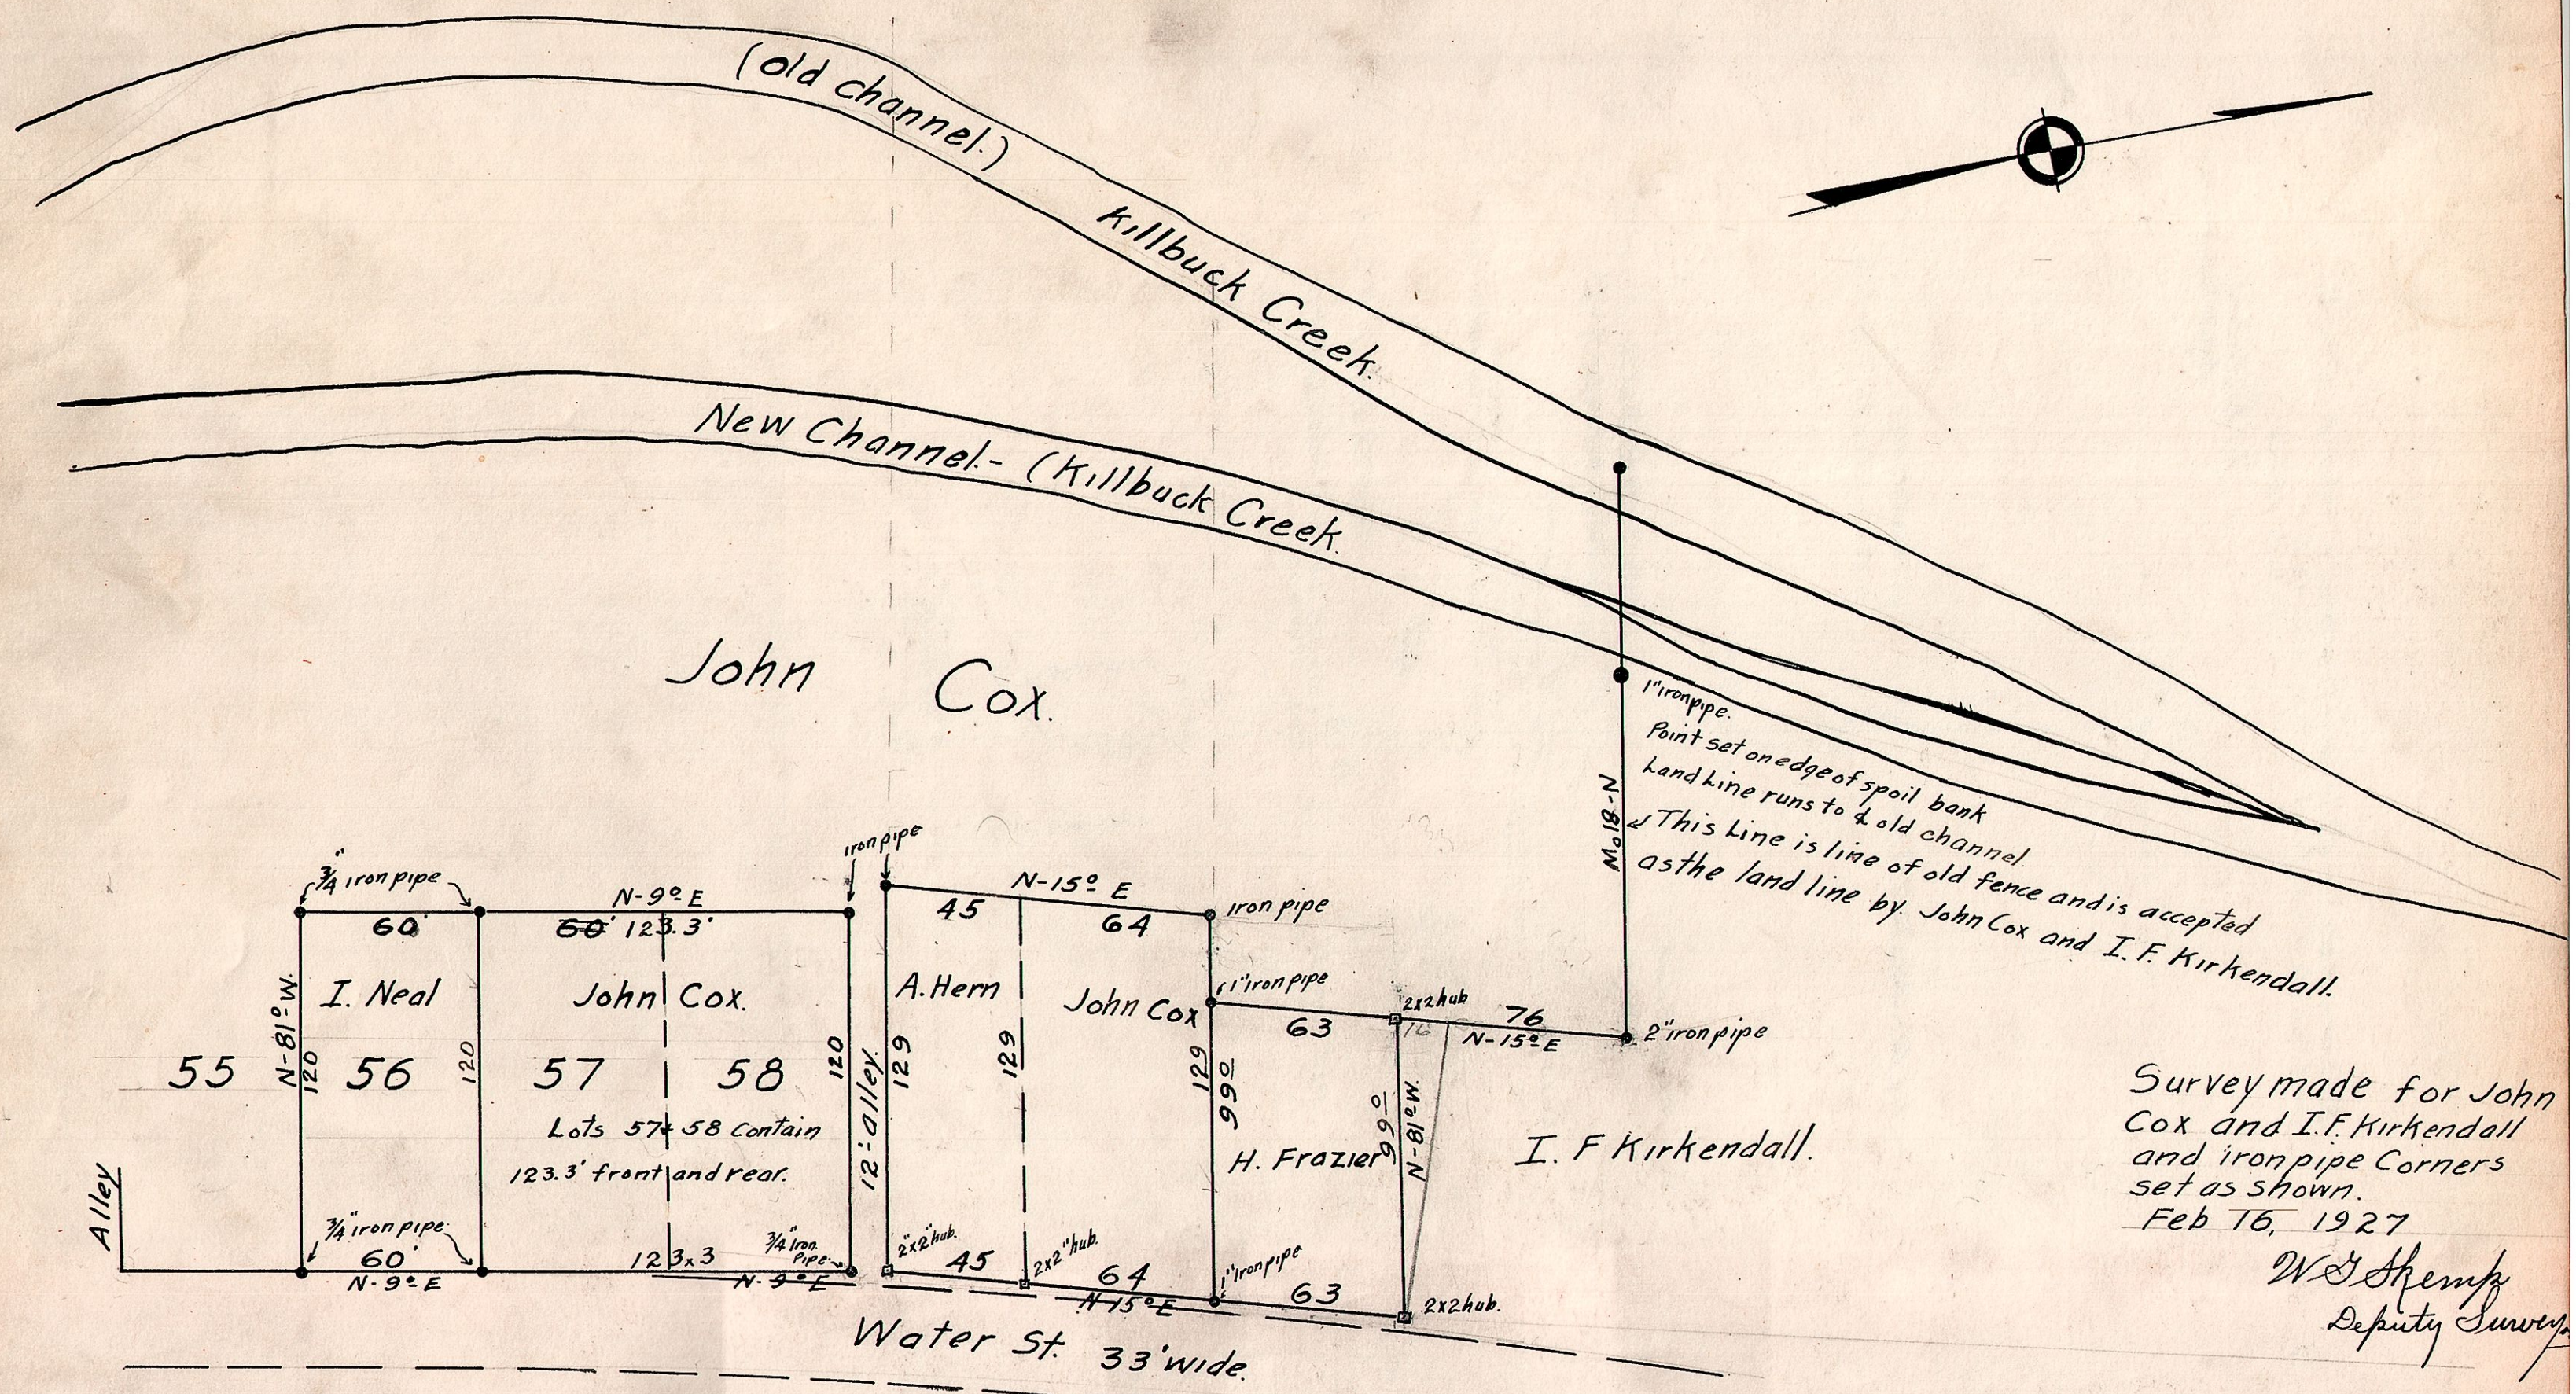

Survey made for John Cox and I. F. Kirkendall and iron pipe Corners set as shown.
Feb 16, 1927

W. G. Skemp
Deputy Surveyor

Lot 58 is same as Lot #13 of J.C. Duncans 3rd Subdivision.

Note:- Water street is Curved and varies from land lines as shown.