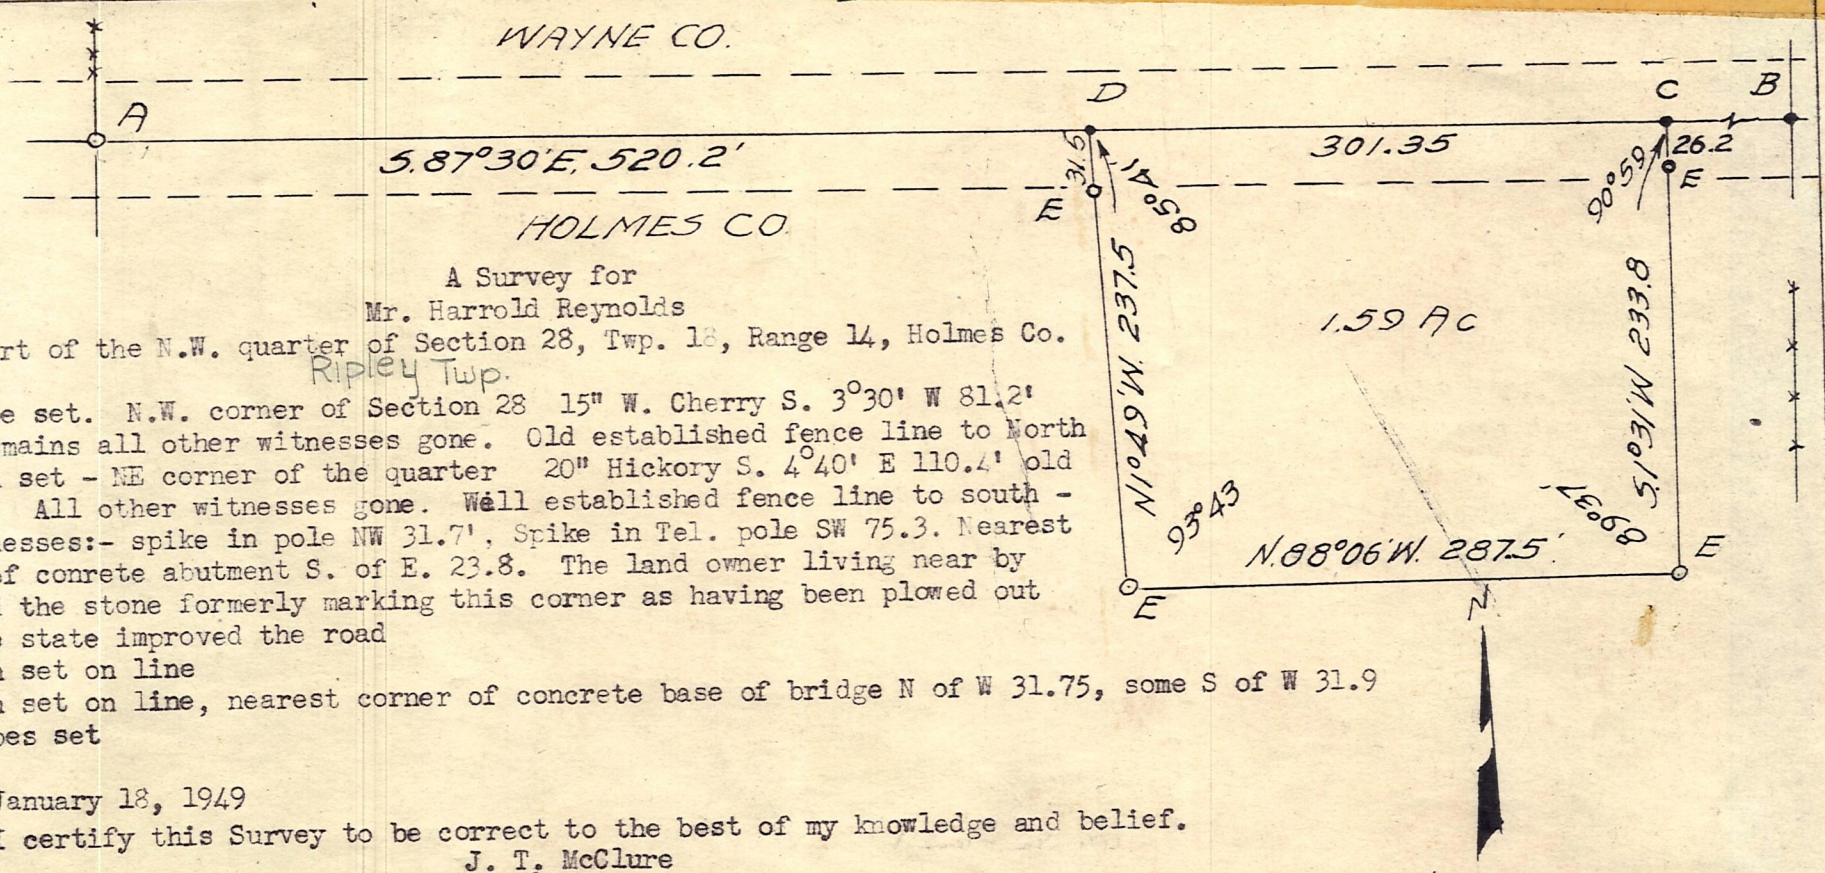

A Survey for
Mr. Harrold Reynolds

in the N. part of the N.W. quarter of Section 28, Twp. 18, Range 14, Holmes Co. Ohio.
Ripley Twp.

A - Iron pipe set. N.W. corner of Section 28 15" W. Cherry S. 3°30' W 81.2' Stump remains all other witnesses gone. Old established fence line to North

B - Iron pin set - NE corner of the quarter 20" Hickory S. 4°40' E 110.4' old witness. All other witnesses gone. Well established fence line to south - New witnesses:- spike in pole NW 31.7', Spike in Tel. pole SW 75.3. Nearest corner of conrete abutment S. of E. 23.8. The land owner living near by reported the stone formerly marking this corner as having been plowed out when the state improved the road

C - Iron pin set on line

D - Iron pin set on line, nearest corner of concrete base of bridge N of W 31.75, some S of W 31.9

E - Iron pipes set

Time - January 18, 1949

I certify this Survey to be correct to the best of my knowledge and belief.

J. T. McClure
2403

Survey Record 5-364