

Berlin Twp. T9, R-5, 3rd. 1/4, Lot 38


W. E. QUICKSALL and ASSOCIATES, CONSULTING ENGINEERS
New Philadelphia, Ohio

Index No. _____
Sheet 1 of 1

PROJECT: Revised Dilgard Plat

Made by WEQ Date 10/12/61

Comm. No. 358 Chkd. by _____ Date _____

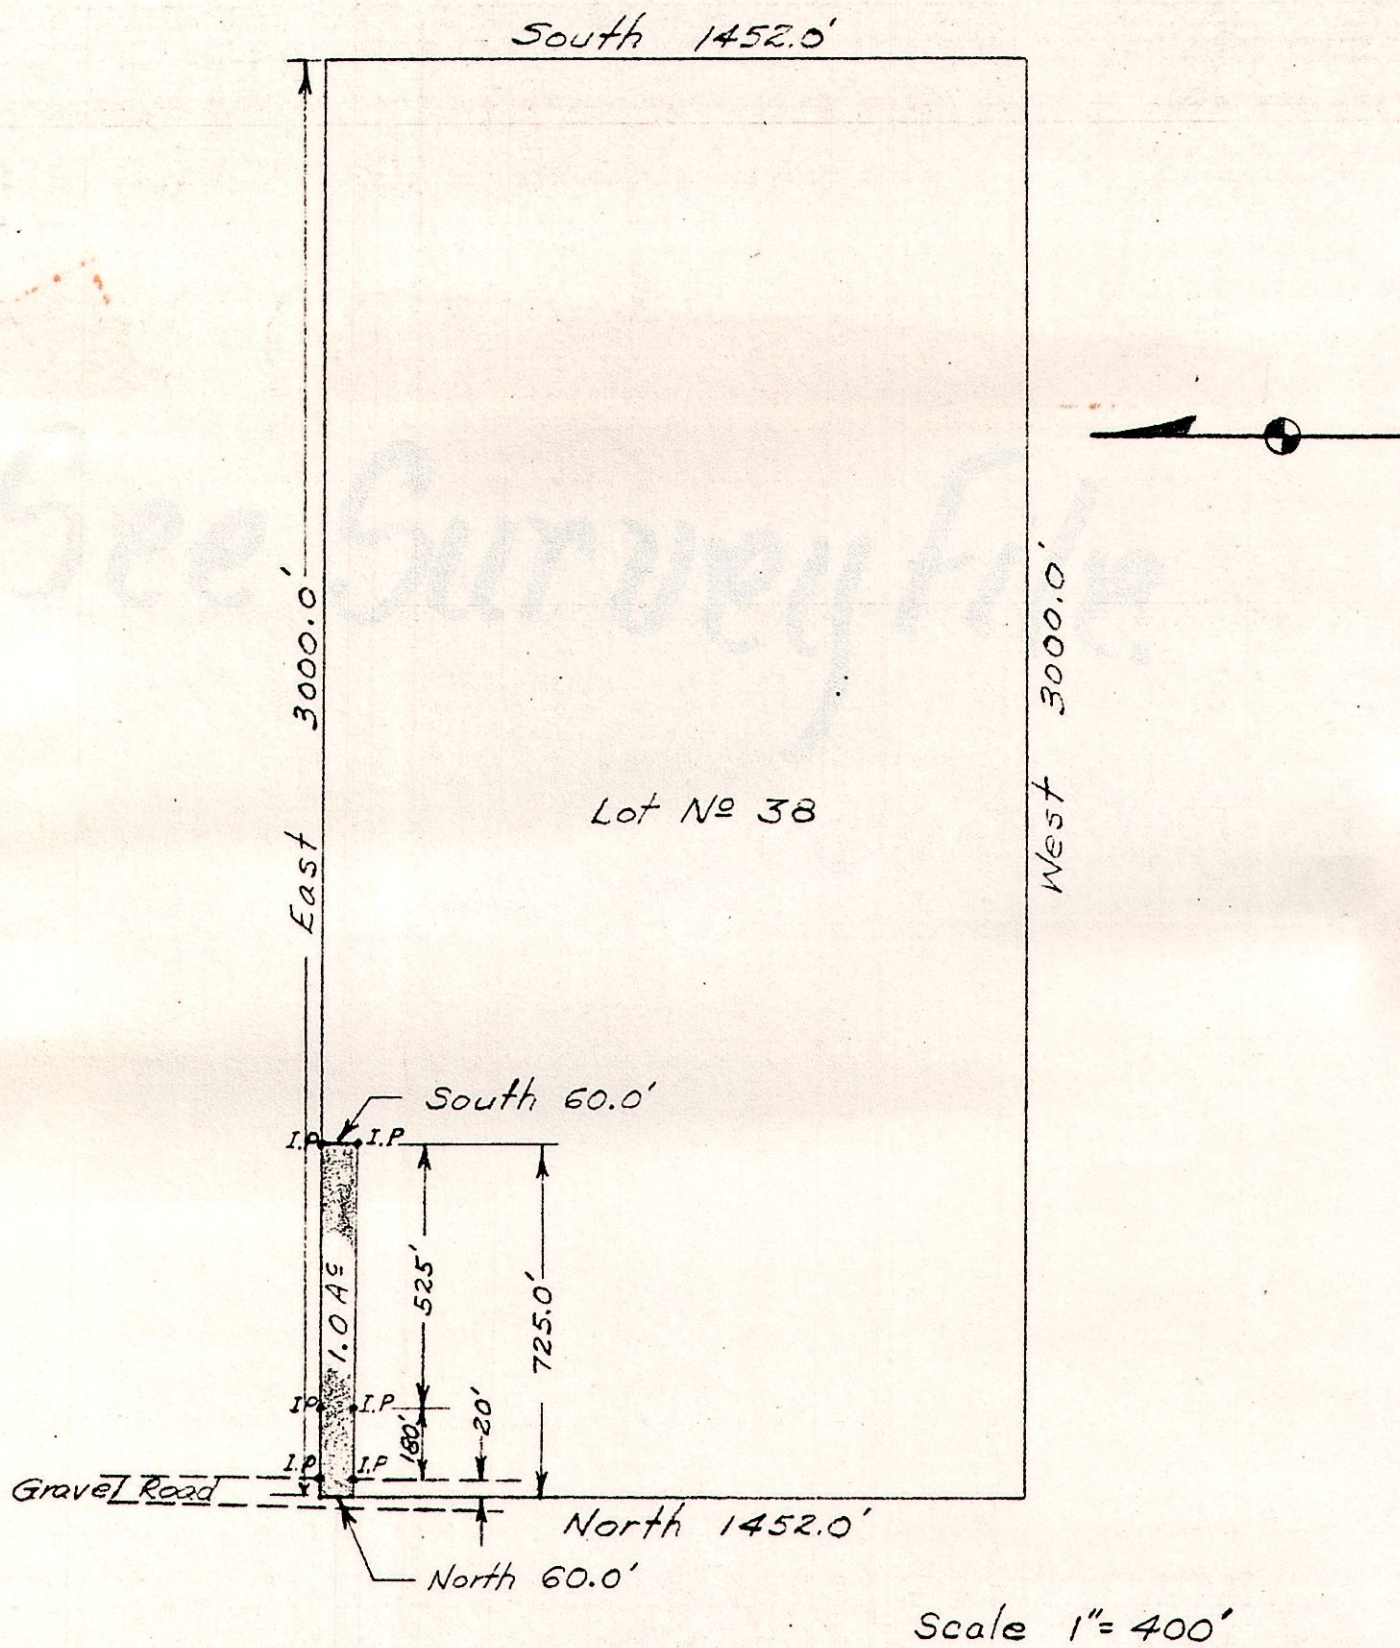


Scale 1" = 400'